

**PLAN** 

SCALE: 1/4" = 1'-0"

**ISSUE FOR BID** 

**REFUSE SHED 'A' ROOF FRAMING PLAN** 

SHEET NOTES:

1. SEE S20.01 FOR SHEET NOTES.

STEEL BEAMS WITH MINIMUM (10) #12 SCREWS.

CONN AT SIDELAP AND CONN AT SUPPORT.

2. CEE GIRT: MINIMUM 12 GAGE WITH 8" WEB, AND 3 1/2" FLANGE. FASTEN TO

3. 3"-METAL DECK IS N-32, 18 GAGE, G90 FINISH ATTACH ROOF SHEATHING TO (METAL DECK WITH A MINIMUM #10 SCREW @12" EW.


4. SEE UNTOPPED METAL DECK TYPICAL DETAIL FOR MORE INFORMATION ON

ALLOWABLE DIAPHRAGM SHEAR STRENGTH SHALL HAVE 394 PLF CAPACITY OR GREATER.

DRAWING NO.

**S20.03** 

OF

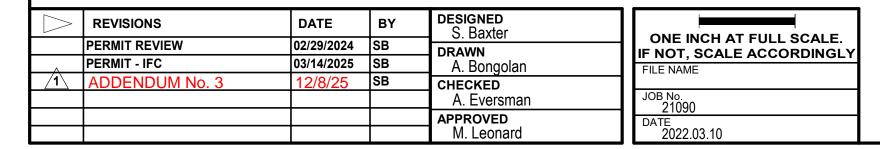








## PROJECT NAME

SILVERDALE RECYCLING AND GARBAGE FACILITY


REDEVELOPMENT

KITSAP COUNTY, WASHINGTON

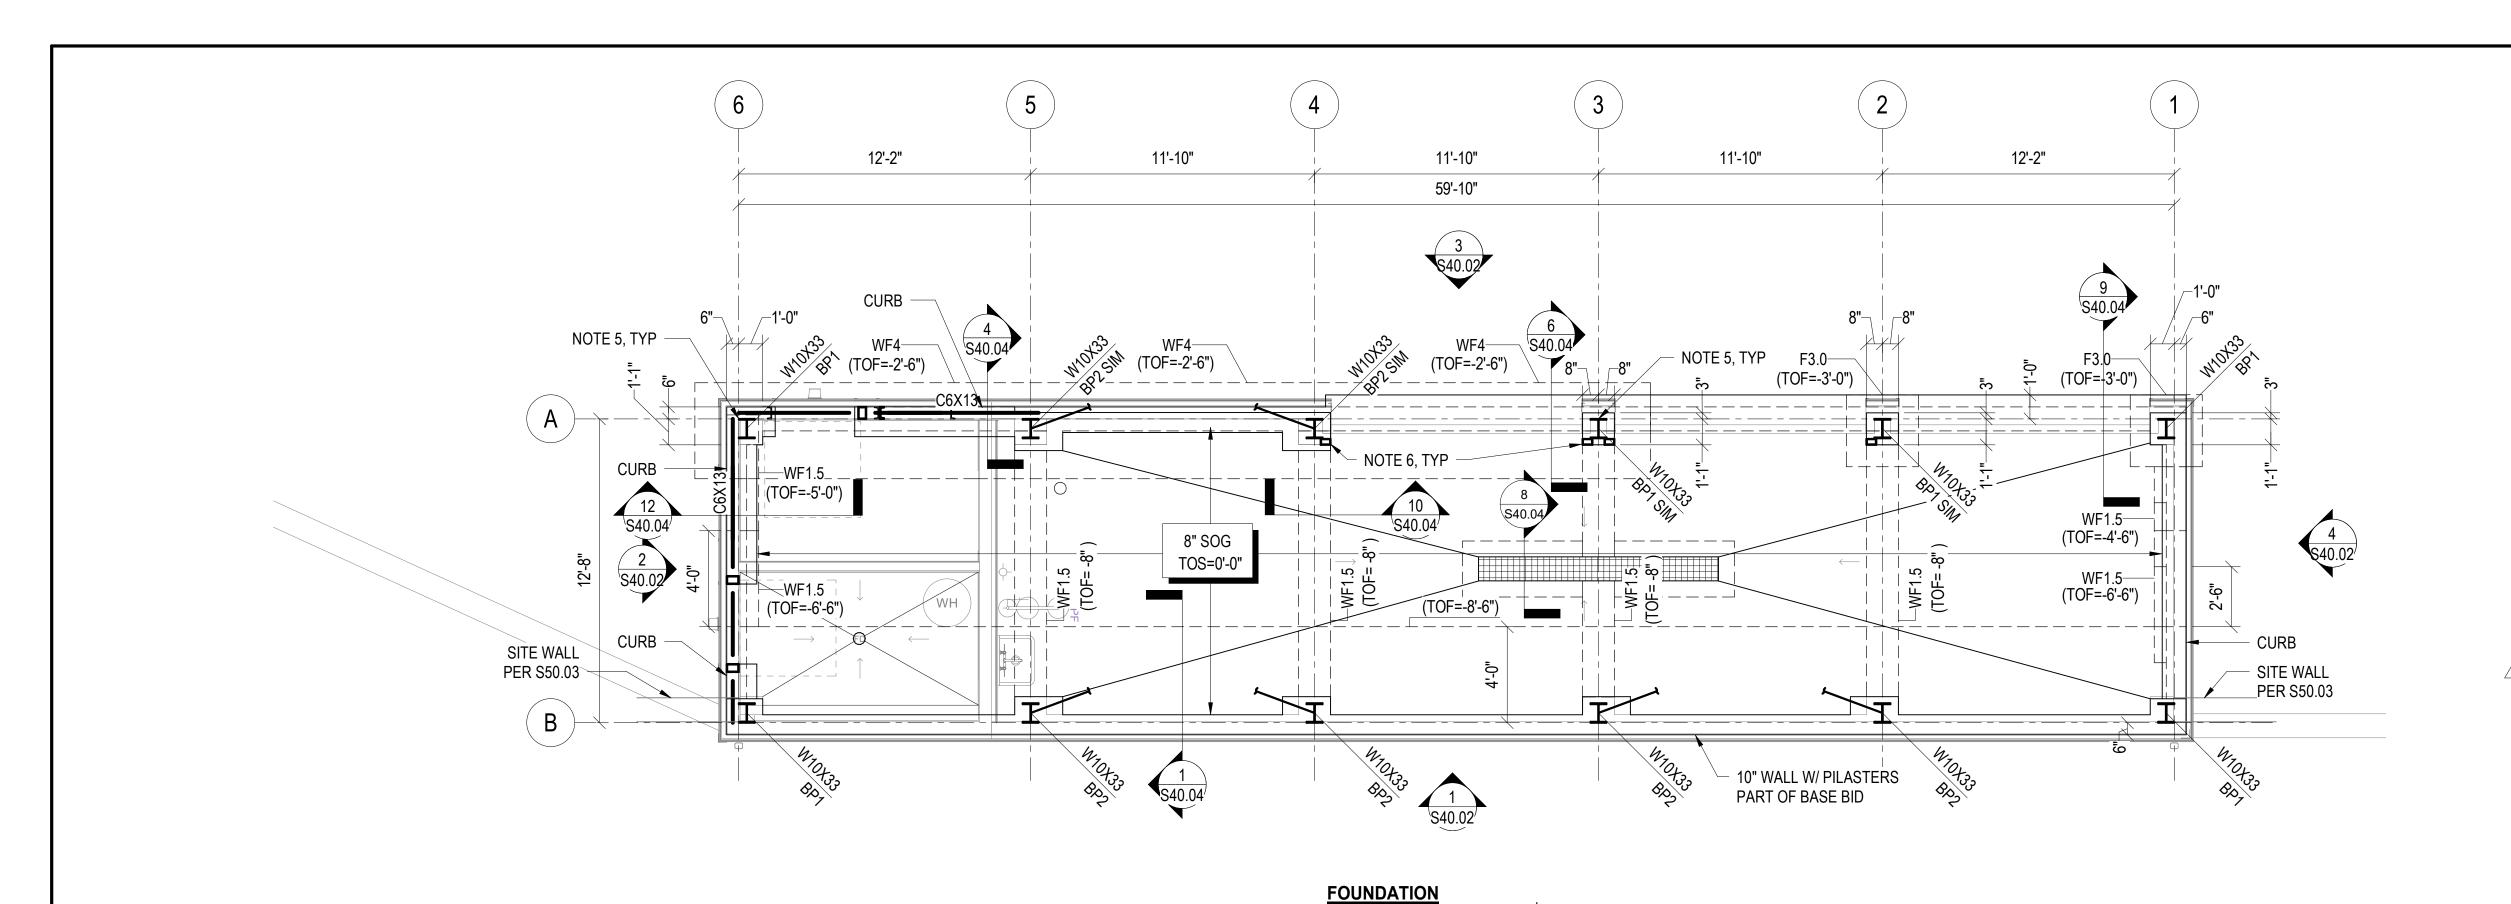

#### SHEET NOTES:

- 1. SLAB-ON-GRADE IS 8" THICK WITH #5 @ 8" OC EACH WAY CENTERED IN SLAB. SLOPE SLAB TO DRAIN AS INDICATED, WHERE OCCURS, MAINTAIN SLAB COVER REQUIREMENTS.
- 2. PROVIDE CONSTRUCTION JOINTS OR CONTROL JOINTS IN SLAB ON GRADE PER S10.05.
- 3. MAXIMUM VERTICAL SPACING OF CLADDING ZEE GRITS IS 4FT OC. MINIMUM ZEE GIRTS PROPERTIES ARE AS FOLLOWS: ZEE GRIT: 6"x2.5" - 14 gauge 1xx = 5.011 in<sup>4</sup>
- 4. WALL CLADDING PANNELS SHALL BE MINIMUM 24 GAGE. SCREW PANELS AS FOLLOWS: WALL ZONE 4: #12 @ 12" OC WALL ZONE 5: #12 @ 12" OC REFER TO \$40.05 FOR WIND LOADING DIAGRAM AND ZONE MAP.
- 5. FACE OF STEEL COLUMN SHALL BE ALIGNED WITH GRID LINES.
- 6. HSS5X3X1/4 FOR COILING DOOR RAIL SUPPORT. SEE DETAIL 9/S40.05. COORDINATE LOCATION WITH COILING DOOR MANUFACTURER.
- 7. FOR GENERAL NOTES SEE S10.01 S10.05.
- 8. FOR TYPICAL DETAILS SEE \$10.10 \$10.21.
- SEE ARCHITECTURAL DETAILS FOR 2X FURRING AT 2'-0" OC ON ROOF. ATTACH FURRING TO METAL DECK WITH #8 X1.25" SCREWS @12" OC. THE SHEATHING ABOVE FURRING SHOULD BE ATTACHED TO FURRING WITH #8 X1.5 SCREWS @ 12" OC.

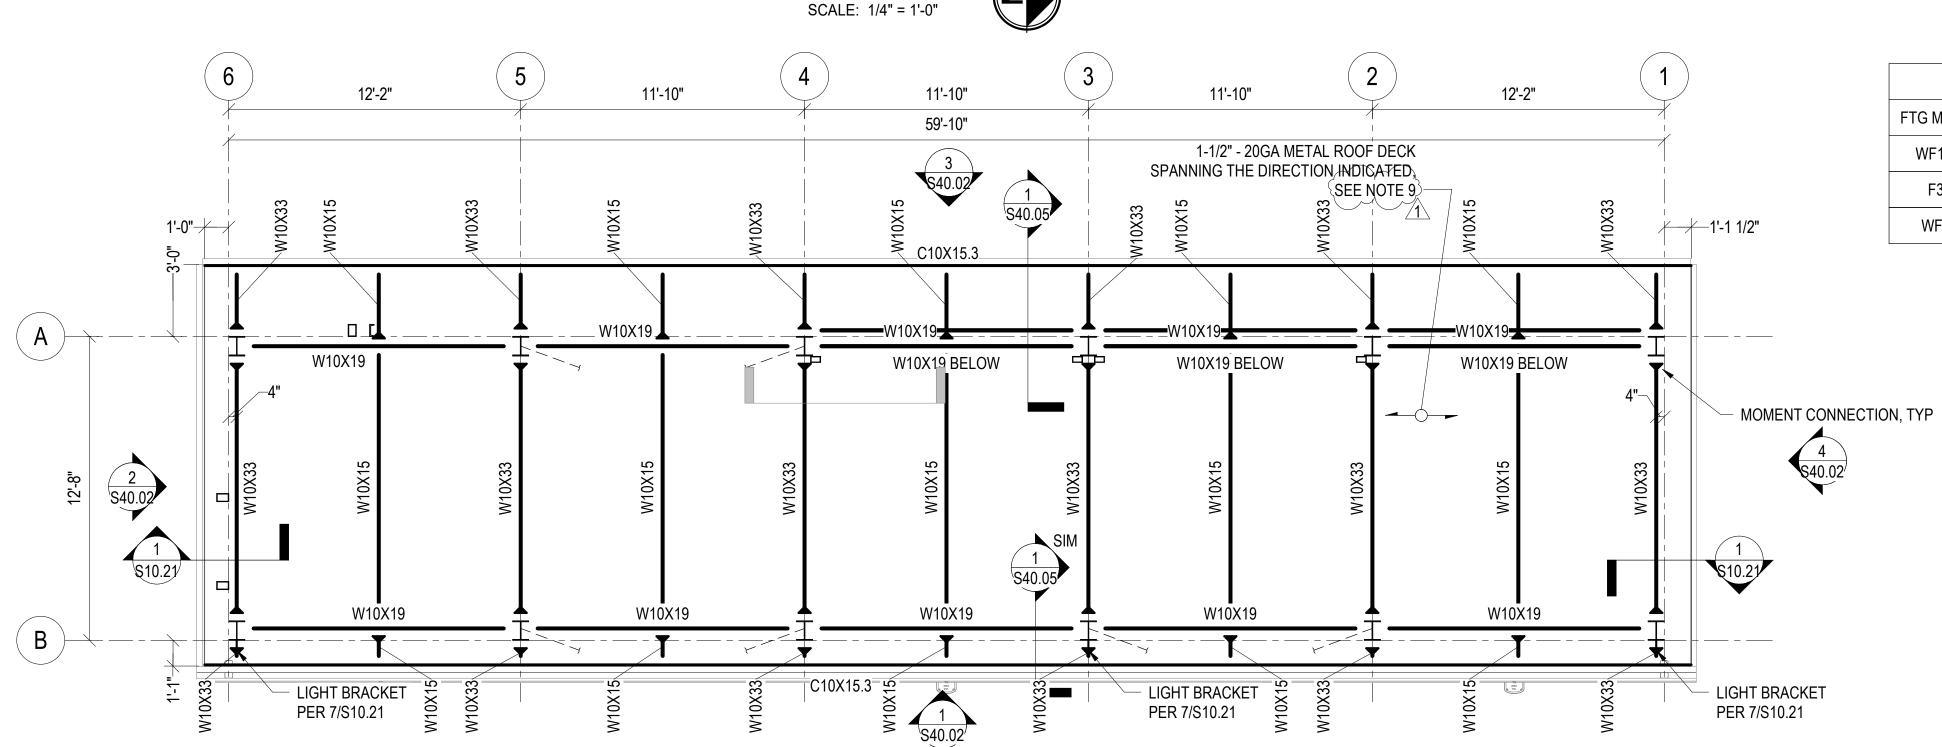

**PLAN** 

FTG MARK	WIDTH	THICKNESS	REINFORCEMENT	REMARKS
WF1.5	1'-4"	1'-6"	(3) #5 TOP & BOTTOM W/ #5 @ 12" TRANS	-
F3	3'-0" x 3'-0"	1'-0"	(4) #5 TOP & BOT	-
WF4	4'-0"	2'-6"	(6) #5 TOP & BOT W/ #5 @ 12" STIRUPS	-

FOOTING SCHEDULE


**GENERAL SHEET NOTES:** 

- 1. ALL DETAILS SHALL BE PART OF BID ALTERNATE 1 UNLESS NOTED OTHERWISE.
- 2. EAST RETAINING WALL WITH PILASTERS IS PART OF BASE BID. IN THE EVENT THE BID ALTERNATE 1 IS NOT SELECTED REBAR INTERSECTING EAST RETAINING WALL WILL BE INSTALLED WITH FORM SAVER REBAR COUPLER

# **ISSUE FOR BID**

**DESIGNED** S. Baxter REVISIONS PERMIT REVIEW 02/29/2024 DRAWN PERMIT - IFC 03/14/2025 SB A. Bongolan CHECKED A. Eversman APPROVED M. Leonard

ONE INCH AT FULL SCALE.
IF NOT, SCALE ACCORDINGLY 2022.03.10

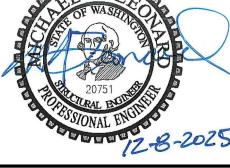

KITSAP COUNTY DEPT. OF PUBLIC WORKS 614 DIVISION STREET MS-26 PORT ORCHARD, WA 98366 TEL:(360) 337-5777 FAX:(360) 337-4867

SCALE: 1/4" = 1'-0"



PROJECT NAME

SILVERDALE RECYCLING AND GARBAGE FACILITY REDEVELOPMENT KITSAP COUNTY, WASHINGTON

LHHW BUILDING FOUNDATION AND ROOF PLAN DRAWING NO. OF

**S40.01** 

ROOF TYPE	MATERIAL	DESCRIPTION
RF-1		METAL ROOF PANEL  WATERPROOF MEMBRANE; SELF-ADHERED  1/2" PLYWOOD SUBSTRATE (SEE STRUCTURAL FOR FASTENING)  METAL ROOF DECK PER STRUCTURAL

FLOOR TYPE	MATERIAL	DESCRIPTION
		8" CONCRETE SLAB PER STRUCTURAL
		REINFORCEMENT PER STRUCTURAL
	4 4 4 4 4 4 4 4 4 4 4 4 4 4 4 4 4 4 4 4	VAPOR BARRIER
FL-1		GRAVEL BASE PER STRUCTURAL
		COMPACTED EARTH PER STRUCTURAL

EXTERIOR WALL TYPE	MATERIAL	DESCRIPTION
8C01>	INT EXT	FLUID APPLIED CONCRETE WATERPROOFING  CAST-IN-PLACE CONCRETE PER STRUCTURAL  REINFORCEMENT PER STRUCTURAL
⊗8SM1>		- 8" WIDE STEEL WALL GIRT - METAL PANEL SIDING


REVISIONS
DATE
BY
DESIGNED
Designer

1 ADDENDUM No. 3
12/7/25
DRAWN
Author
CHECKED
Checker
APPROVED
Approver

ONE INCH AT FULL SCALE.
IF NOT, SCALE ACCORDINGLY
FILE NAME

JOB No.
21090

DATE
DECEMBER 2025

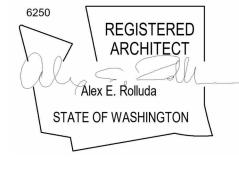





PROJECT NAME


SILVERDALE RECYCLING AND GARBAGE FACILITY

KITSAP COUNTY, WASHINGTON

| REFUSE SHED A ASSEMBLY TYPES

DRAWING NO. OF

A20.03

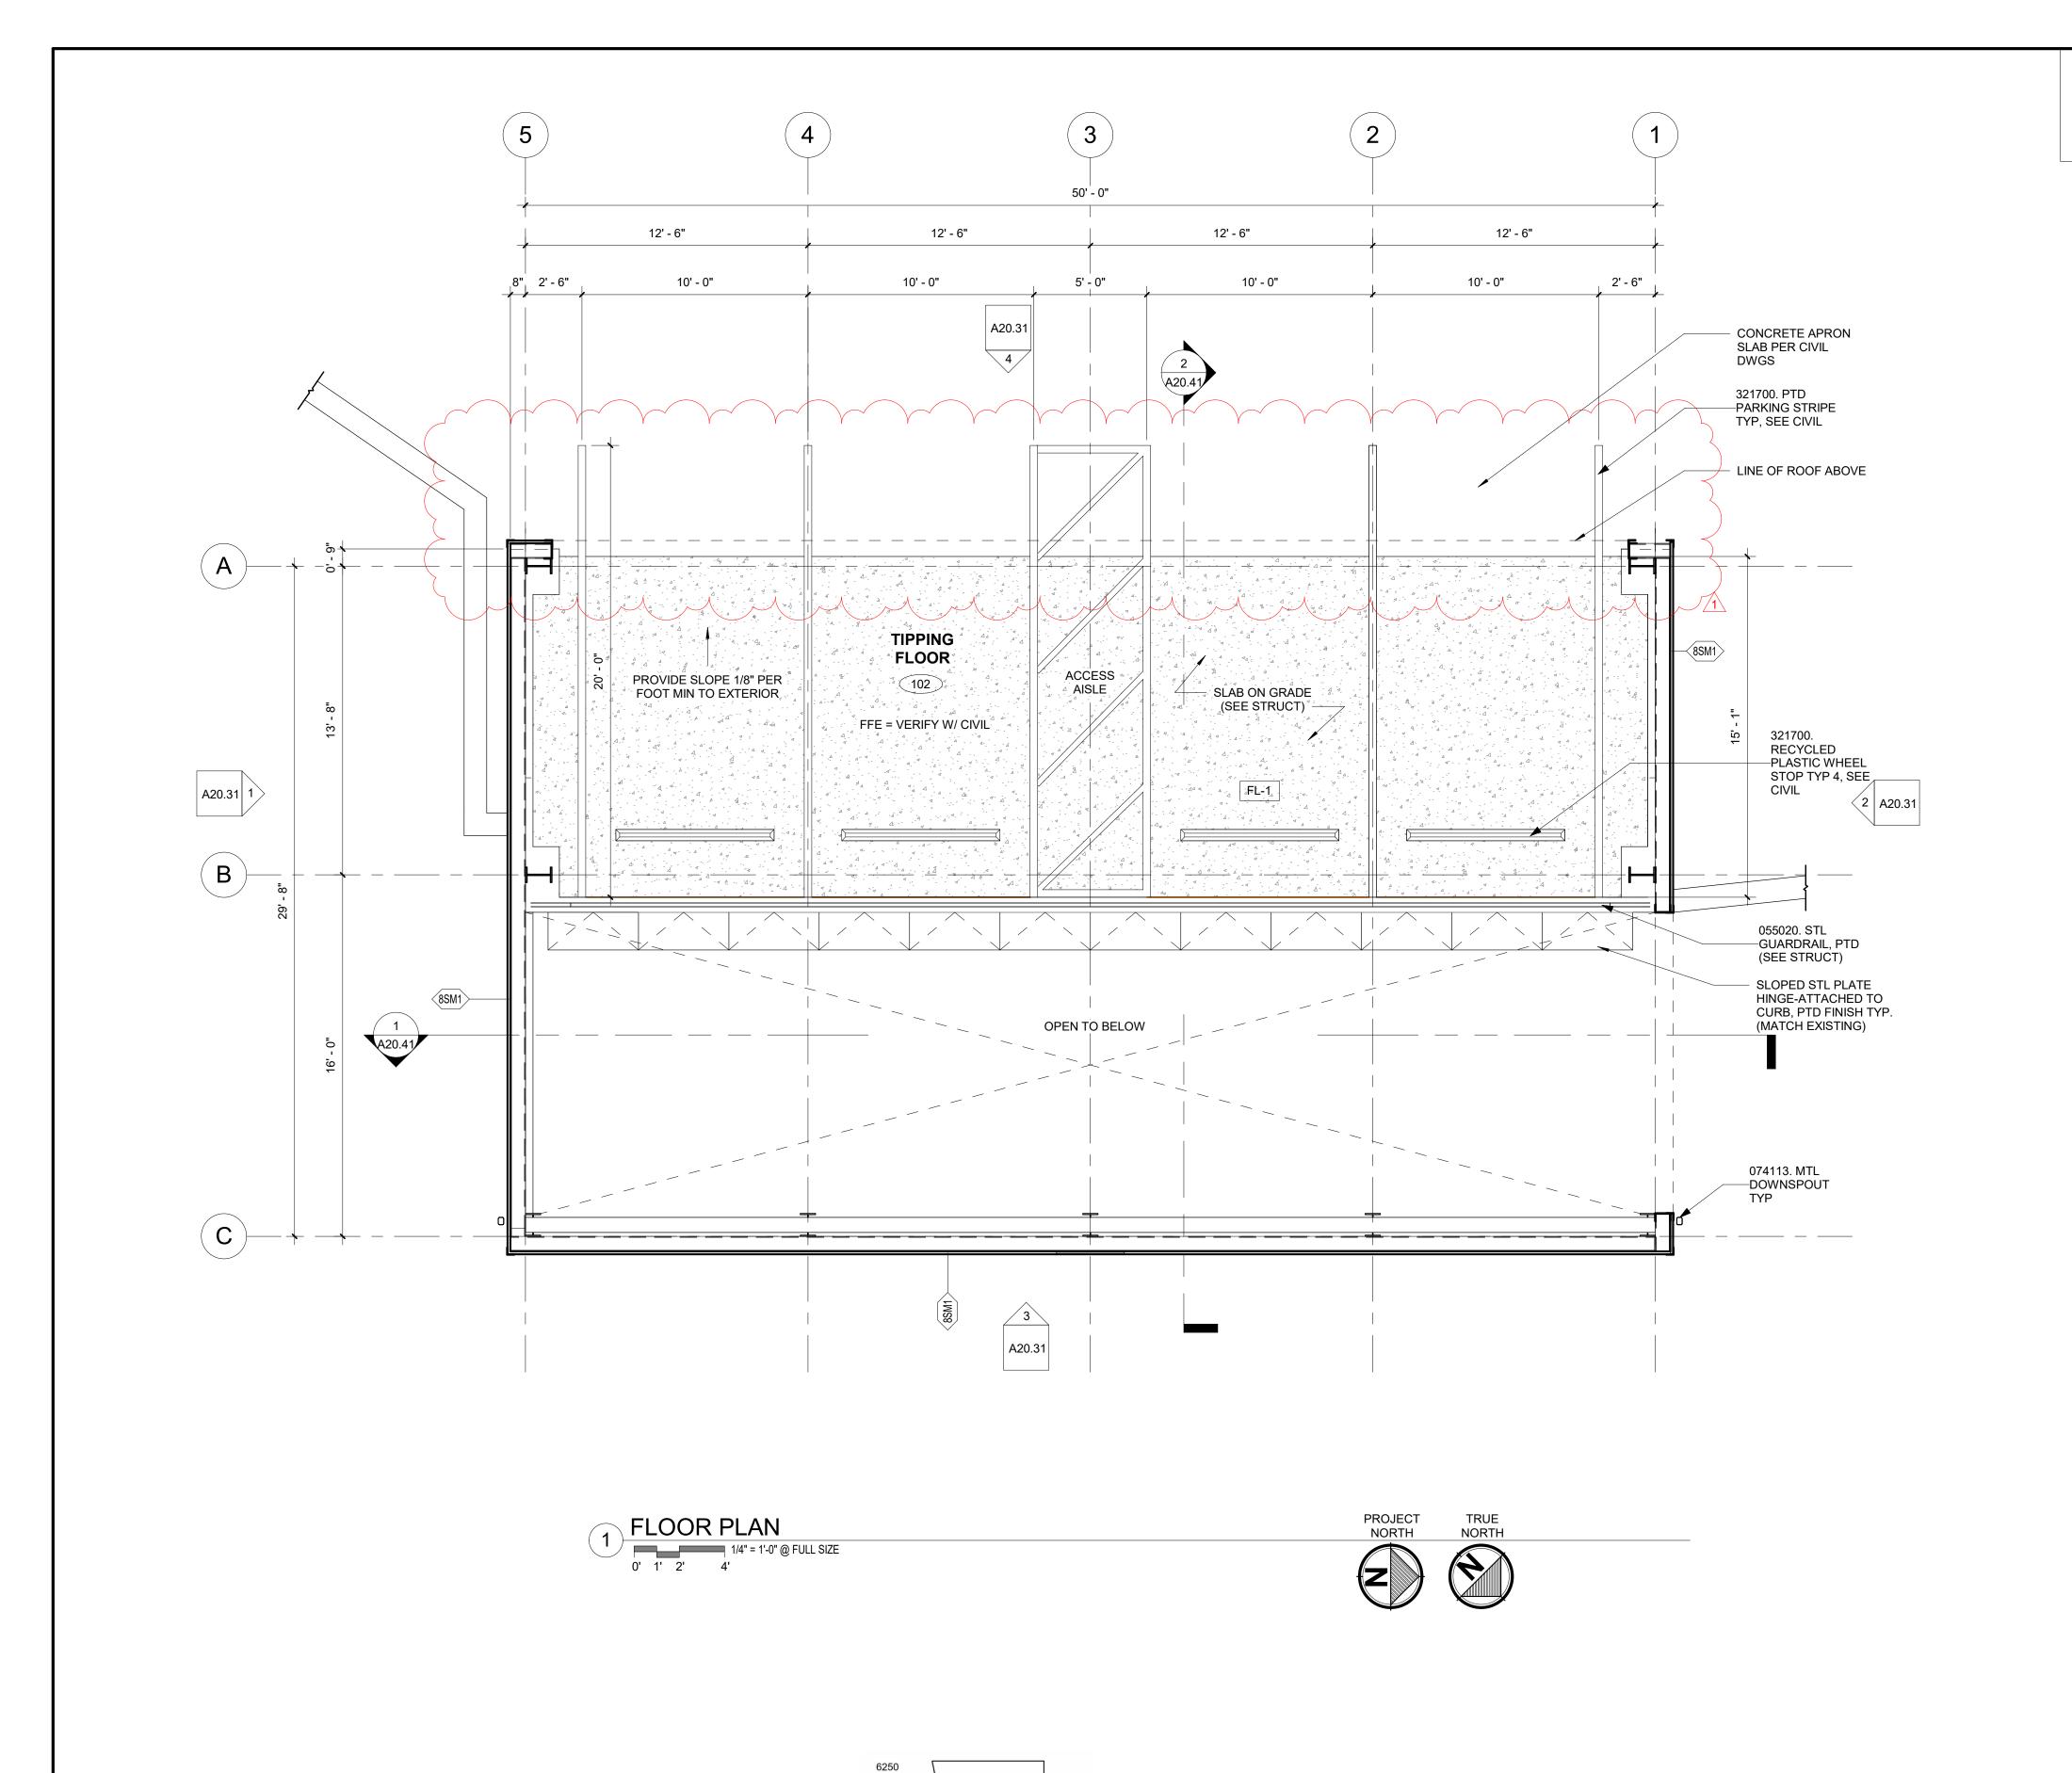

**FLOOR PLAN GENERAL NOTES** 

FOR MECHANICAL, ELECTRICAL, PLUMBING, FIRE PROTECTION, MISTER, AND STRUCTURAL SYSTEMS, REFERENCE ENGINEERING DRAWINGS, SCHEDULES AND SPECIFICATIONS

- A. DRAWINGS ARE SHOWN TO SCALE AS NOTED AS AIDS IN DETERMINING SIZE AND PROPORTION. ONLY WRITTEN DESCRIPTIONS AND SIZES SHALL BE UTILIZED FOR CONSTRUCTION. DRAWINGS SHALL NOT BE SCALED.
- B. UNLESS NOTED OTHERWISE, DIMENSIONS ON PLANS ARE:
  - FACE OF STUD (F.O.S.)FACE OF CONCRETE (F.O.C.)

  - CENTERLINE OF DOOR AND WINDOW OPENINGS.
- C. FIXTURES AND EQUIPMENT SHOWN ARE FOR COORDINATION PURPOSES ONLY. REFER TO THE MANUFACTURER'S PRODUCT DATA, ENGINEERING DRAWINGS, AND SPECIFICATIONS FOR FIXTURE AND EQUIPMENT DESCRIPTIONS AND LOCATIONS.
- D. PRESERVATION OF ADJACENT OR EXISTING CONSTRUCTION: AVOID DAMAGE TO EXISTING STRUCTURES, SIDEWALKS, CURBS,
- PAVING AND LANDSCAPING.
- PATCH, REPAIR, OR REPLACE ANY ITEMS DAMAGED, OR AS DIRECTED BY THE PROPERTY OWNER.
- E. AVOID UNNECESSARY DISRUPTIONS TO THE FUNCTIONS AND ACTIVITIES OF ADJACENT BUILDINGS.
- F. CAREFULLY REVIEW ALL CONTRACT DOCUMENTS PRIOR TO CONSTRUCTION. BRING DISCREPANCIES OR CONFLICTING DATA TO
- THE ATTENTION OF THE ARCHITECT PRIOR TO COMMENCING WORK. G. UNLESS NOTED OTHERWISE, INSTALL DOORS WITH 4" FROM HINGE
- SIDE OF DOOR TO ADJACENT WALL FRAMING. H. CONTRACTOR TO VERIFY SIZES OF ROUGH DOOR AND WINDOW
- OPENINGS PRIOR TO ORDERING DOORS AND WINDOWS.
- GENERAL CONTRACTOR TO COORDINATE FFE WITH CIVIL DRAWINGS.

**ISSUE FOR BID** 

**DESIGNED**Designer REVISIONS DATE DDENDUM No. 3 DRAWN Author CHECKED Checker APPROVED Approver

ONE INCH AT FULL SCALE.
IF NOT, SCALE ACCORDINGLY

DECEMBER 2025







PROJECT NAME


SILVERDALE RECYCLING AND GARBAGE FACILITY


KITSAP COUNTY, WASHINGTON


**REFUSE SHED A FLOOR PLAN -**LEVEL 1


DRAWING NO.

A20.22

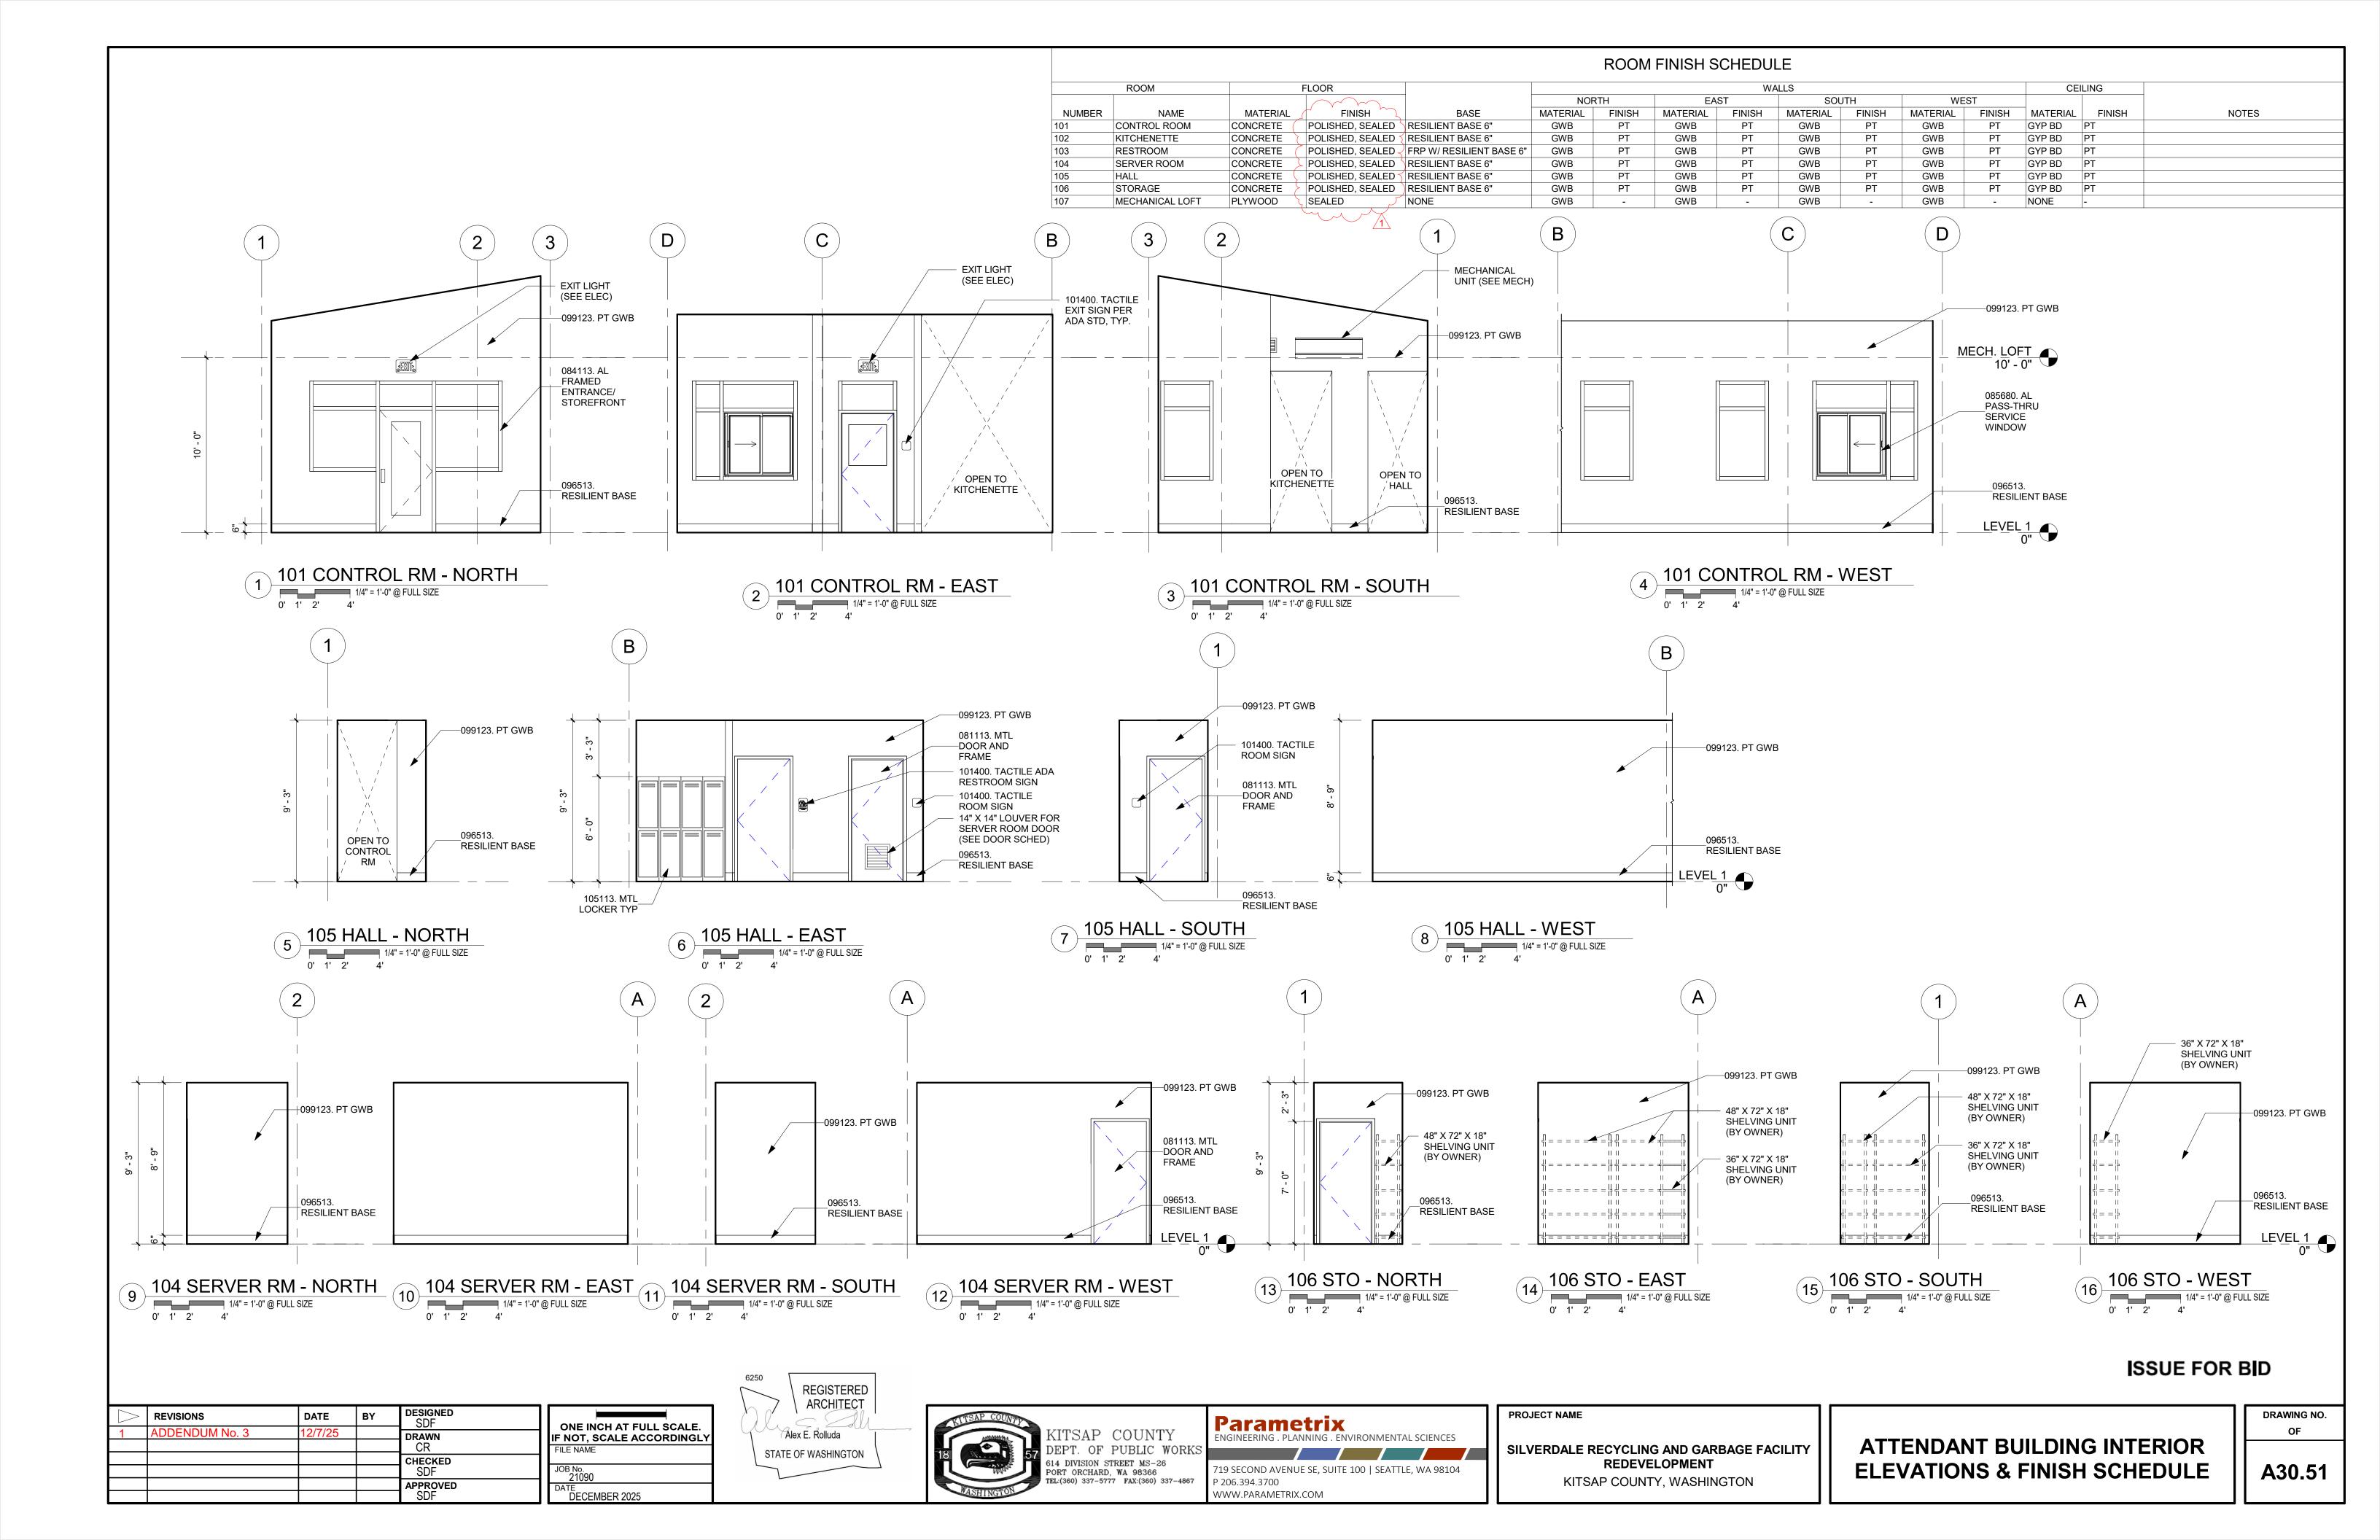

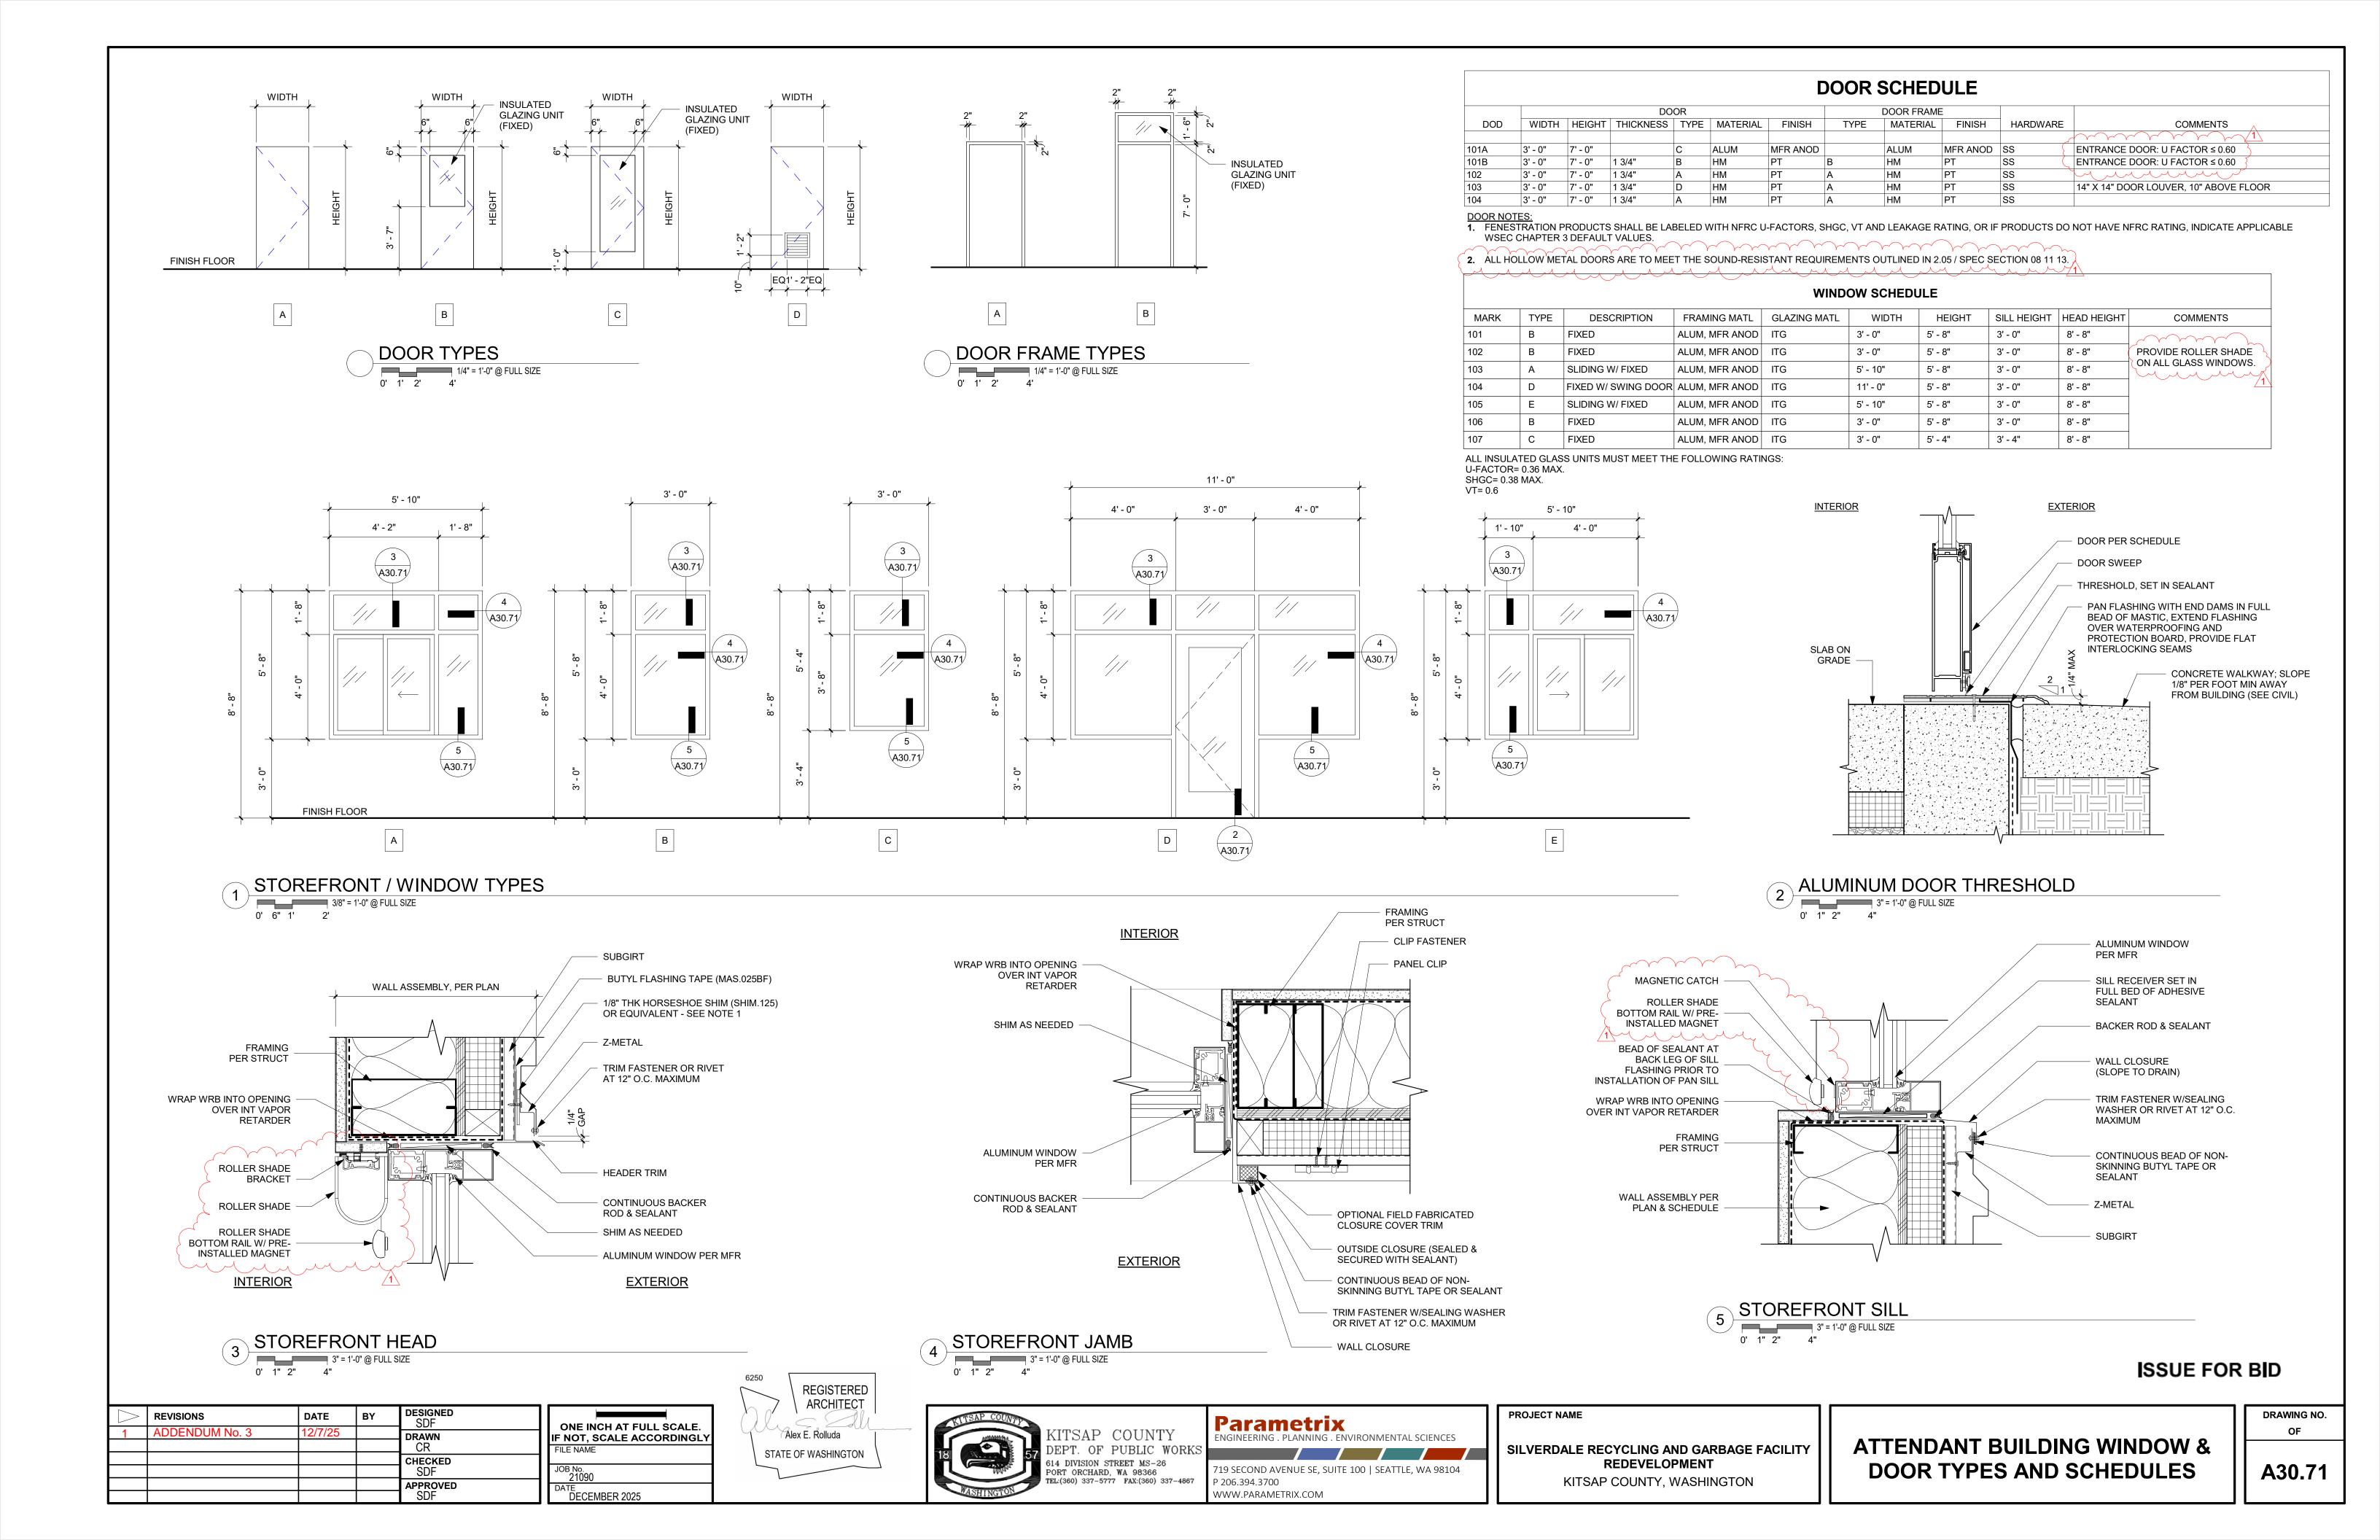


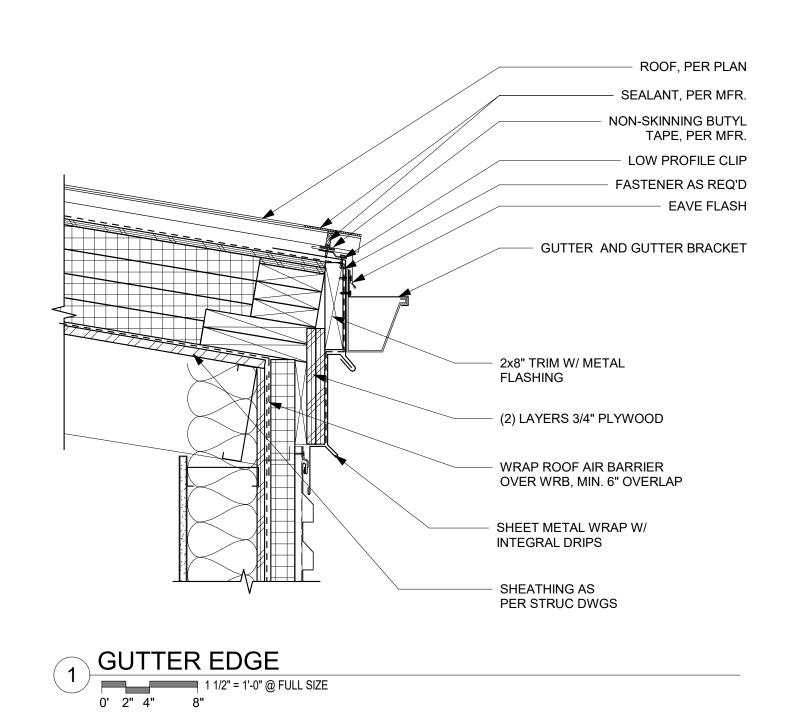

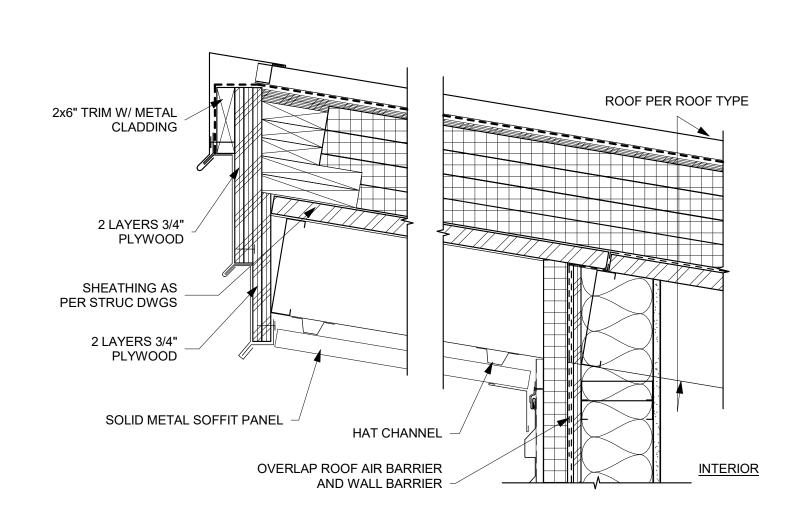



2 HIGH EAVE WITH SOFFIT

1 1/2" = 1'-0" @ FULL SIZE

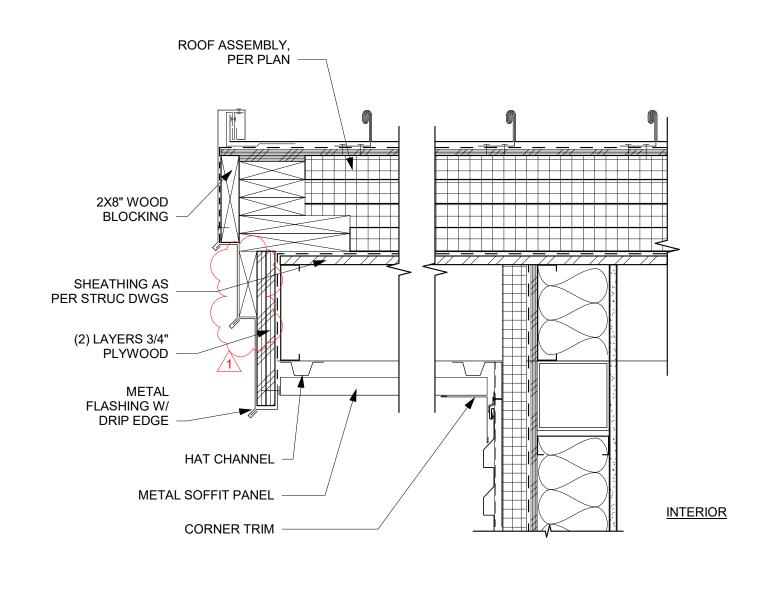





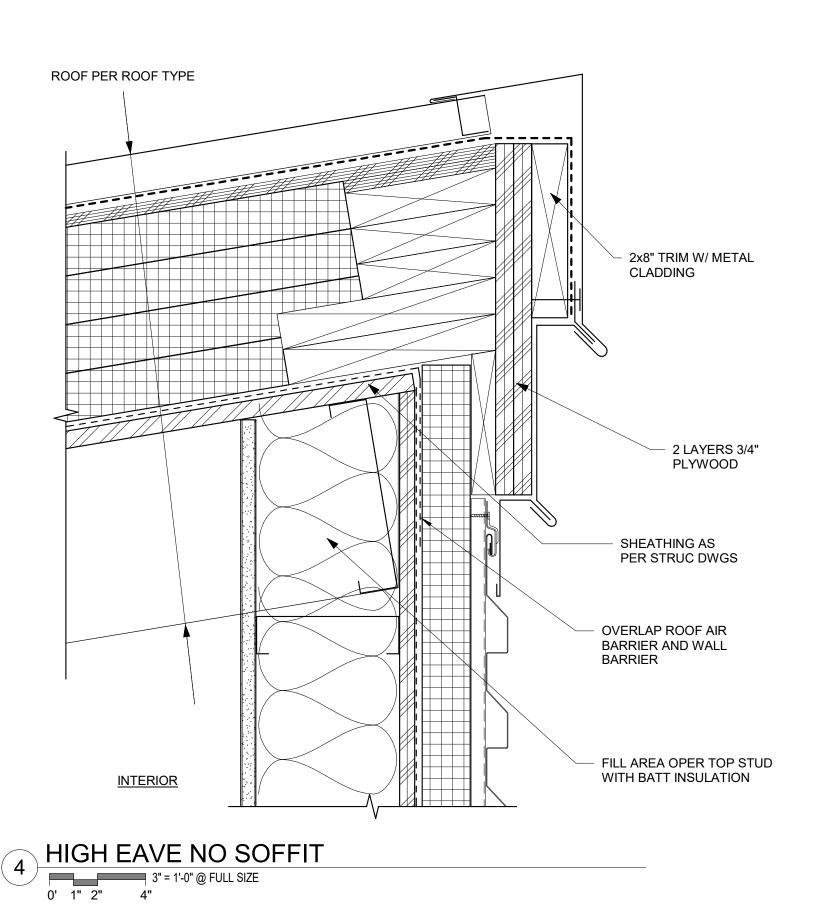


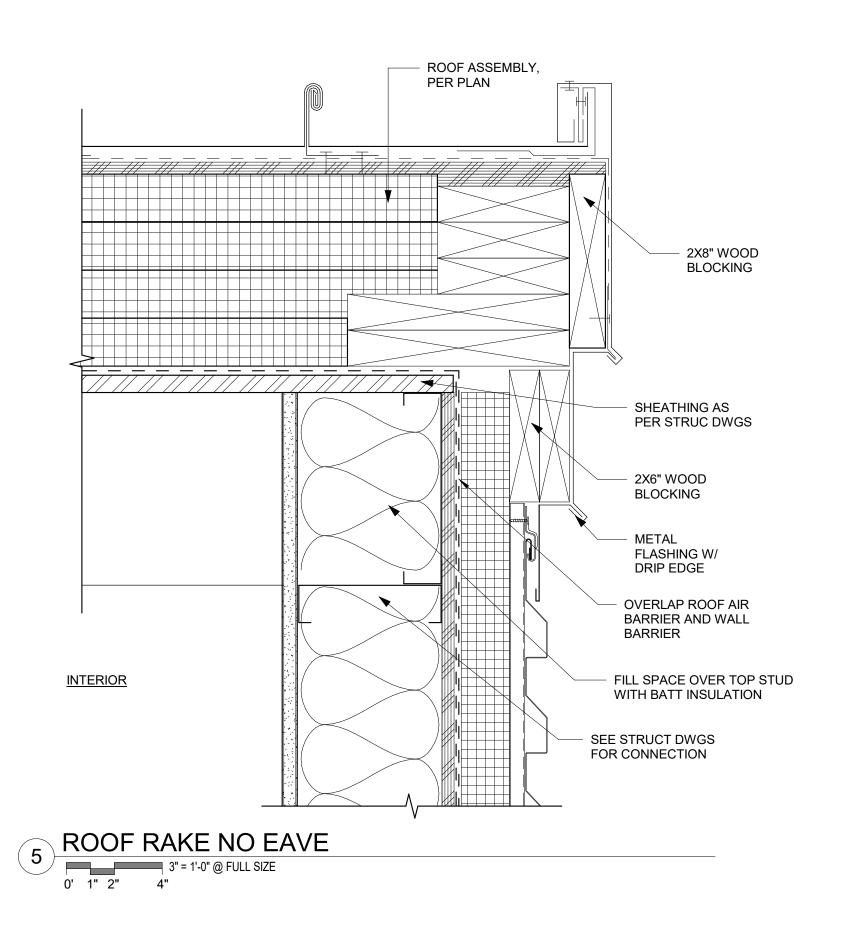

**ISSUE FOR BID** 

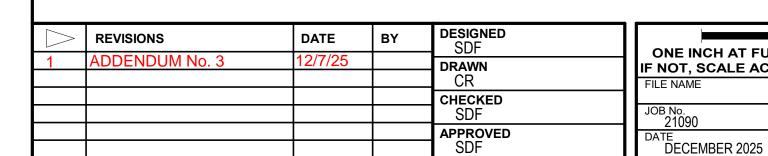

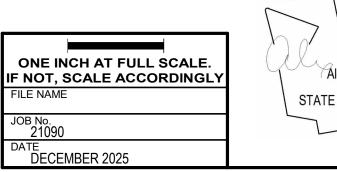

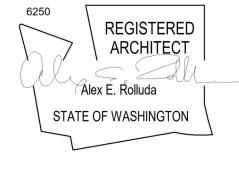



Parametrix
ENGINEERING . PLANNING . ENVIRONMENTAL SCIENCES

719 SECOND AVENUE SE, SUITE 100 | SEATTLE, WA 98104
P 206.394.3700
WWW.PARAMETRIX.COM


PROJECT NAME


SILVERDALE RECYCLING AND GARBAGE FACILITY
REDEVELOPMENT
KITSAP COUNTY, WASHINGTON

ATTENDANT BUILDING DETAILS

DRAWING NO. OF

A30.82

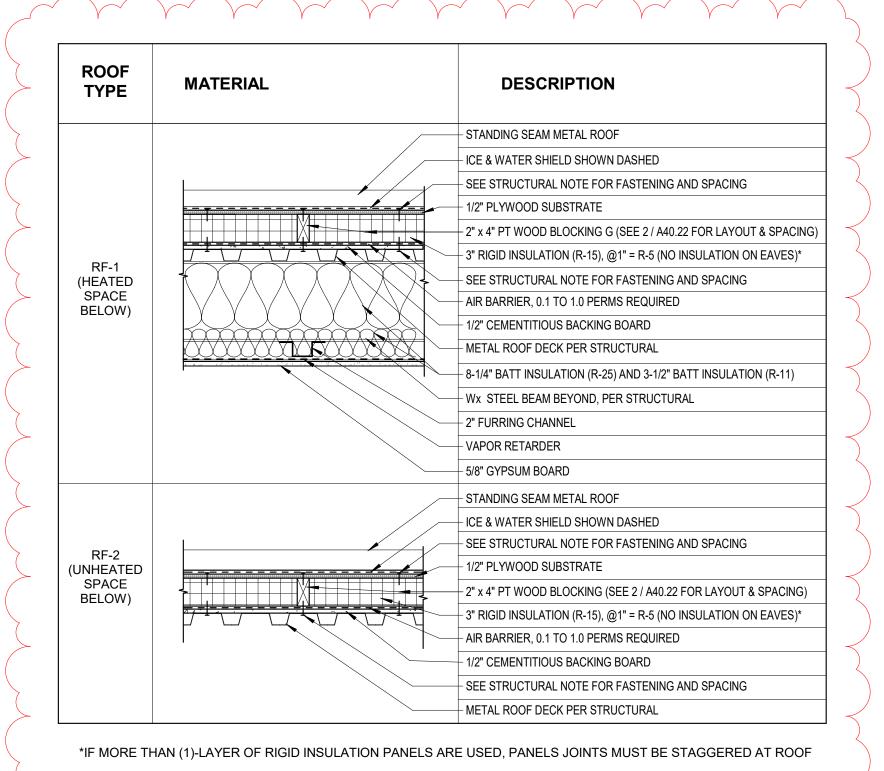

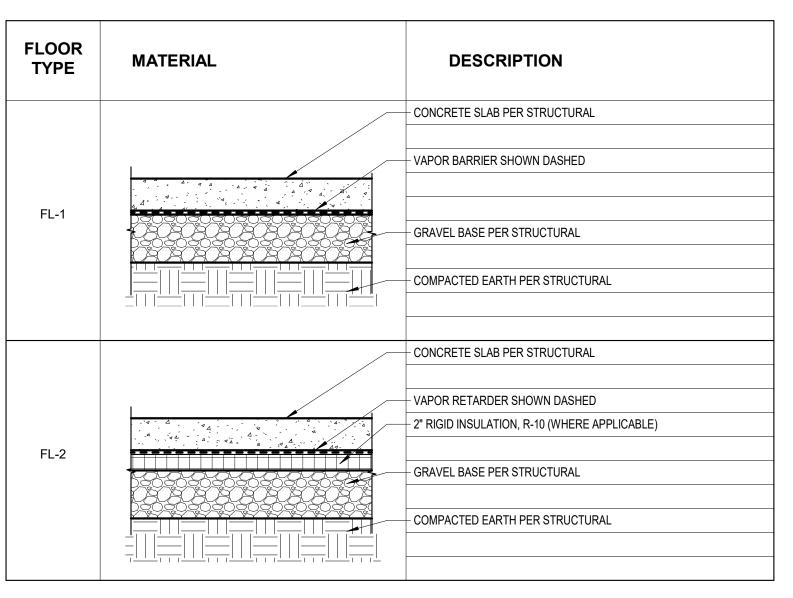

INTERIOR WALL TYPE	MATERIAL	DESCRIPTION
452		(1) LAYER 5/8" GYPSUM WALL BOARD EACH SIDE  6" (6) STEEL STUD FRAMING  3 1/2" SOUND ATTENUATOR, STC-50 (FULLY-FILL SPACE SPACES)

EXTERIOR WALL TYPE	MAT	ERIAL	DESCRIPTION
	<u>INT</u>	EXT	
	<del>                                   </del>		AEP SPAN PC-10 METAL PANEL HORIZONTAL SIDING OR EQUAL
			VERT. SUBGIRT, PER MANUF.
			HORIZ. Z-GIRT, PER MANUF.
6SM1			2" RIGID INSULATION, R-10 CONTINUOUS
			   WEATHER-RESISTANT BARRIER (WRB), 0.1 TO 1.0 PERMS REQUIRED
			PLYWOOD SHEATHING PER STRUCTURAL
			STEEL GIRT PER STRUCTURAL
			STEEL SHATT EN STATES
		<u> </u>	AEP SPAN PC-10 METAL PANEL HORIZONTAL SIDING OR EQUAL
		/ _	VERT. SUBGIRT, PER MANUF.
			HORIZ. Z-GIRT, PER MANUF.
			2" RIGID INSULATION, R-10 CONTINUOUS
			WEATHER-RESISTANT BARRIER (WRB), 0.1 TO 1.0 PERMS REQUIRE
6SM2			PLYWOOD SHEATHING PER STRUCTURAL
			6" STEEL GIRT PER STRUCTURAL
			6" BATT INSULATION, R-24 (FULLY FILL SPACE)
			VAPOR RETARDER, SHOWN DASHED
			7/8" FURRING CHANNEL 1
			5/8" GYPSUM WALL BOARD
			1/2" CEMENT BOARD (GARAGE SIDE)
			2" RIGID INSULATION, R-10
			HORIZ. Z-GIRT
			WEATHER-RESISTANT BARRIER (WRB), 0.1 TO 1.0 PERMS REQUIRE
6SM3			PLYWOOD SHEATHING PER STRUCTURAL
1-HOUR			6" METAL STUD FRAMING PER STRUCTURAL
FIRE-RATED			
SEPARATION			6" BATT INSULATION, R-24 (FULLY FILL SPACE)  VAPOR RETARDER, SHOWN DASHED
			5/8" GYPSUM WALL BOARD (TYPE X)
	ш	<b>√</b> \! <del>     </del>	
			AFR ORAN DO 40 METAL RANEL HORIZONTAL GIRING OR FOLIAL
			AEP SPAN PC-10 METAL PANEL HORIZONTAL SIDING OR EQUAL
			SUBGIRT
4SM1			WEATHER-RESISTANT BARRIER (WRB)
			PLYWOOD SHEATHING PER STRUCTURAL
			4" METAL STUD FRAMING PER SRUCTURAL
		•	
	4.	1	FLUID APPLIED CONCRETE WATERPROOFING
	4.	4 4 4	CAST-IN-PLACE CONCRETE PER PLAN (SEE STRL)
(C01)	, 4 4		REINFORCEMENT PER STRUCTURAL
<u></u>		4	
	. 4	4 , 4 ,	
	4		
		4	FLUID APPLIED CONCRETE WATERPROOFING
		4	CAST-IN-PLACE RETAINING WALL PER PLAN (SEE STRL)
		4.4.	
		-4 - ,4	4" METAL STUD FRAMING
<c02></c02>		- 4	3 1/2" BATT INSULATION, R-11 (FULLY FILL SPACE)
<b>C02</b> →	[[]]		- VAPOR RETARDER
<u>C02</u>		44	
<u>C02</u>		- A-4	5/8" GYPSUM WALL BOARD


**ISSUE FOR BID** 

	REVISIONS	DATE	вү	<b>DESIGNED</b> Designer
1	ADDENDUM No. 3	12/7/25		DRAWN Author
				CHECKED
				Checker  APPROVED
				Approver

ONE INCH AT FULL SCALE.
IF NOT, SCALE ACCORDINGLY
FILE NAME

JOB No.

DATE
DECEMBER 2025

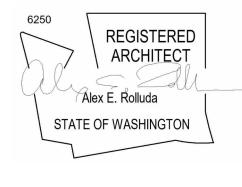





PROJECT NAME


SILVERDALE RECYCLING AND GARBAGE FACILITY
REDEVELOPMENT
KITSAP COUNTY, WASHINGTON


LHHW BUILDING ASSEMBLY TYPES


DRAWING NO.


OF

A40.03

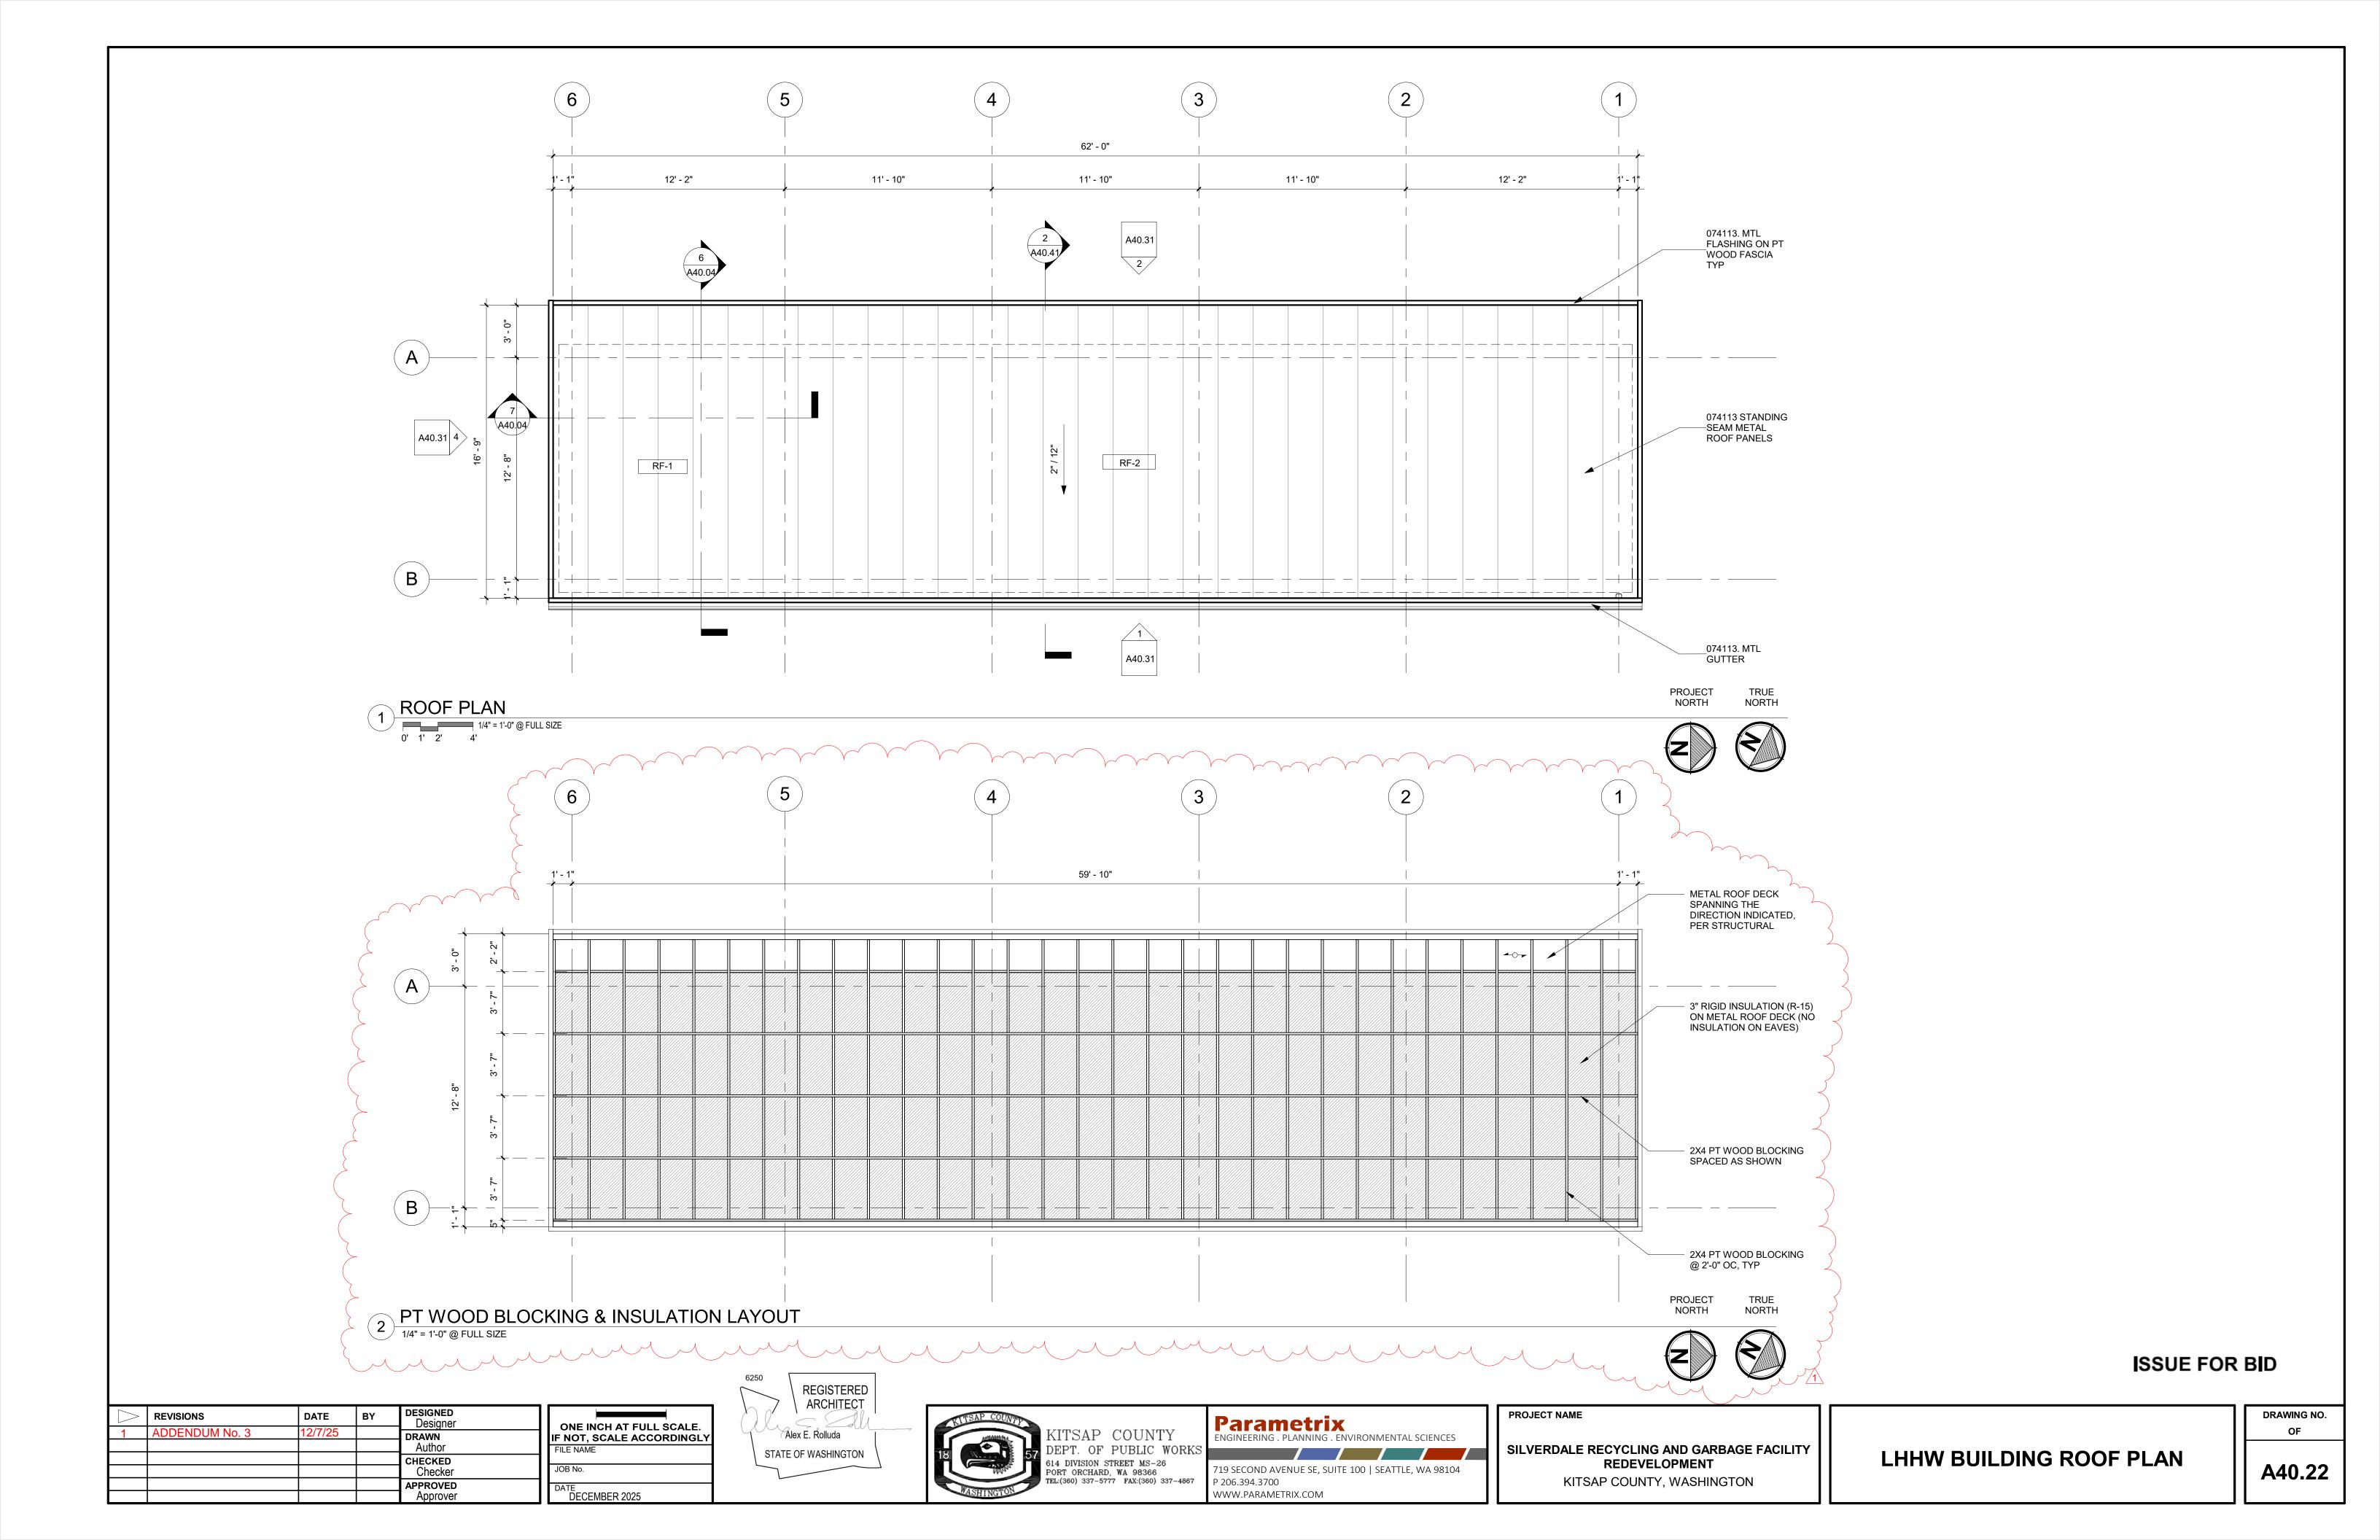


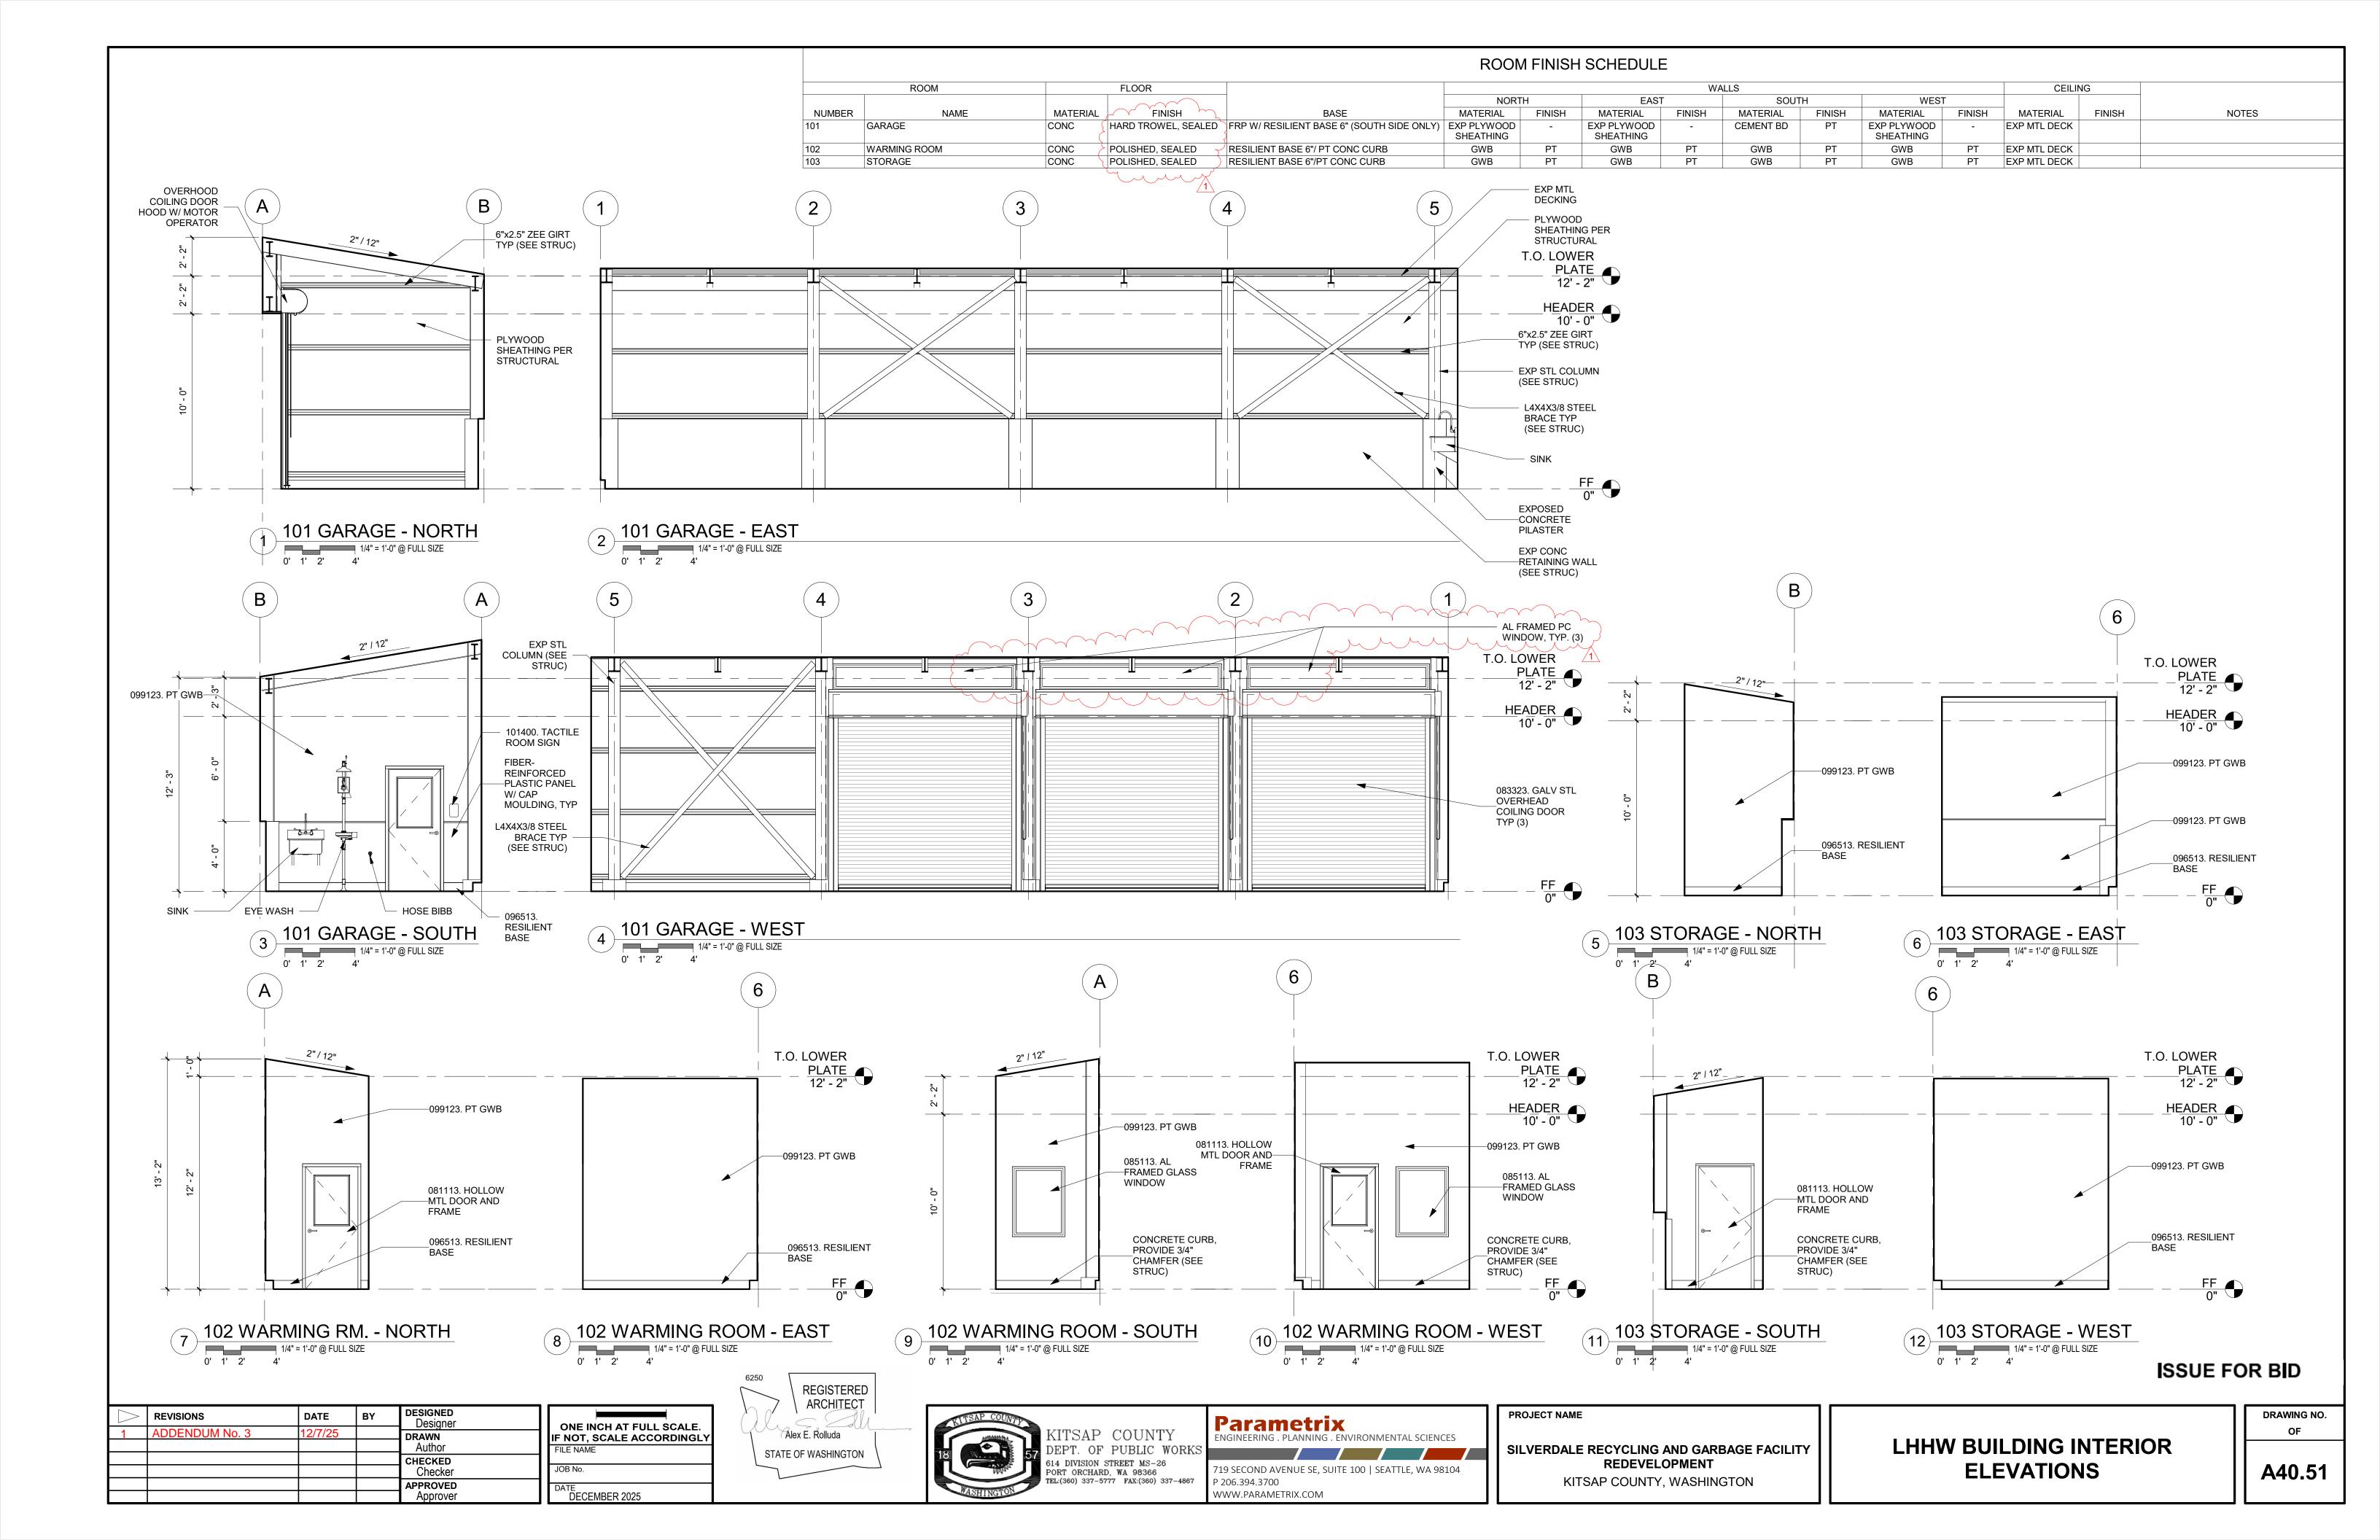

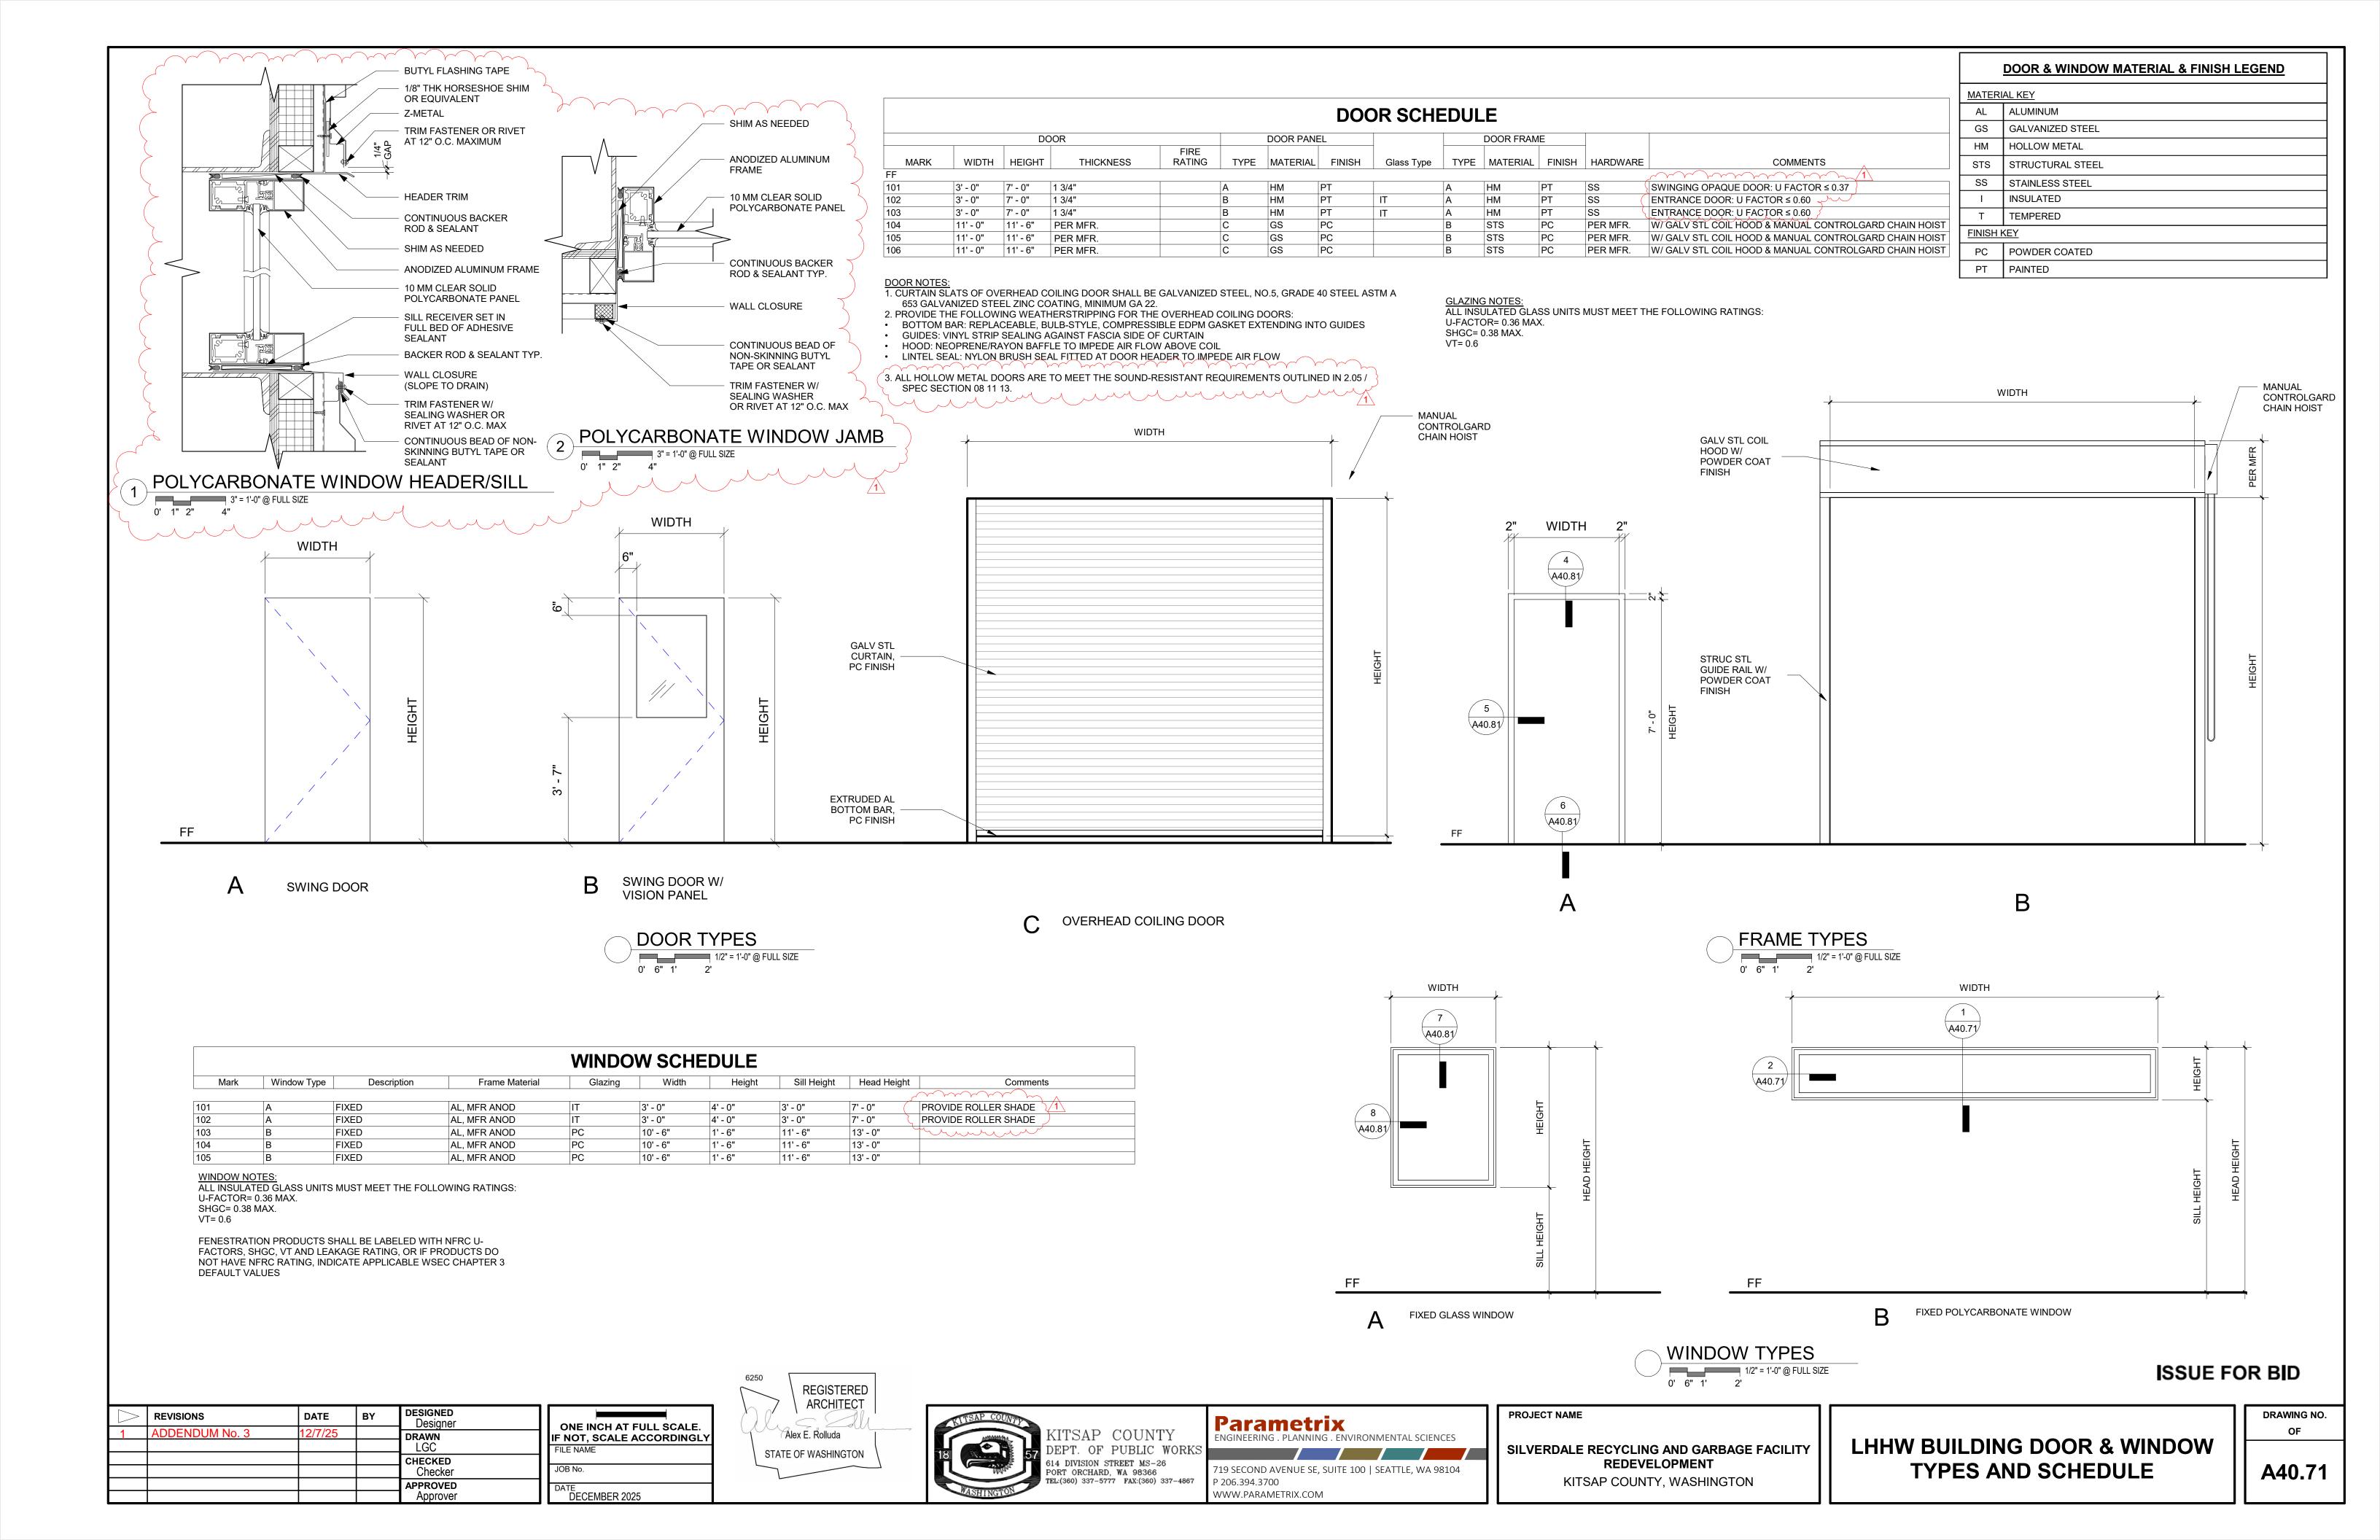


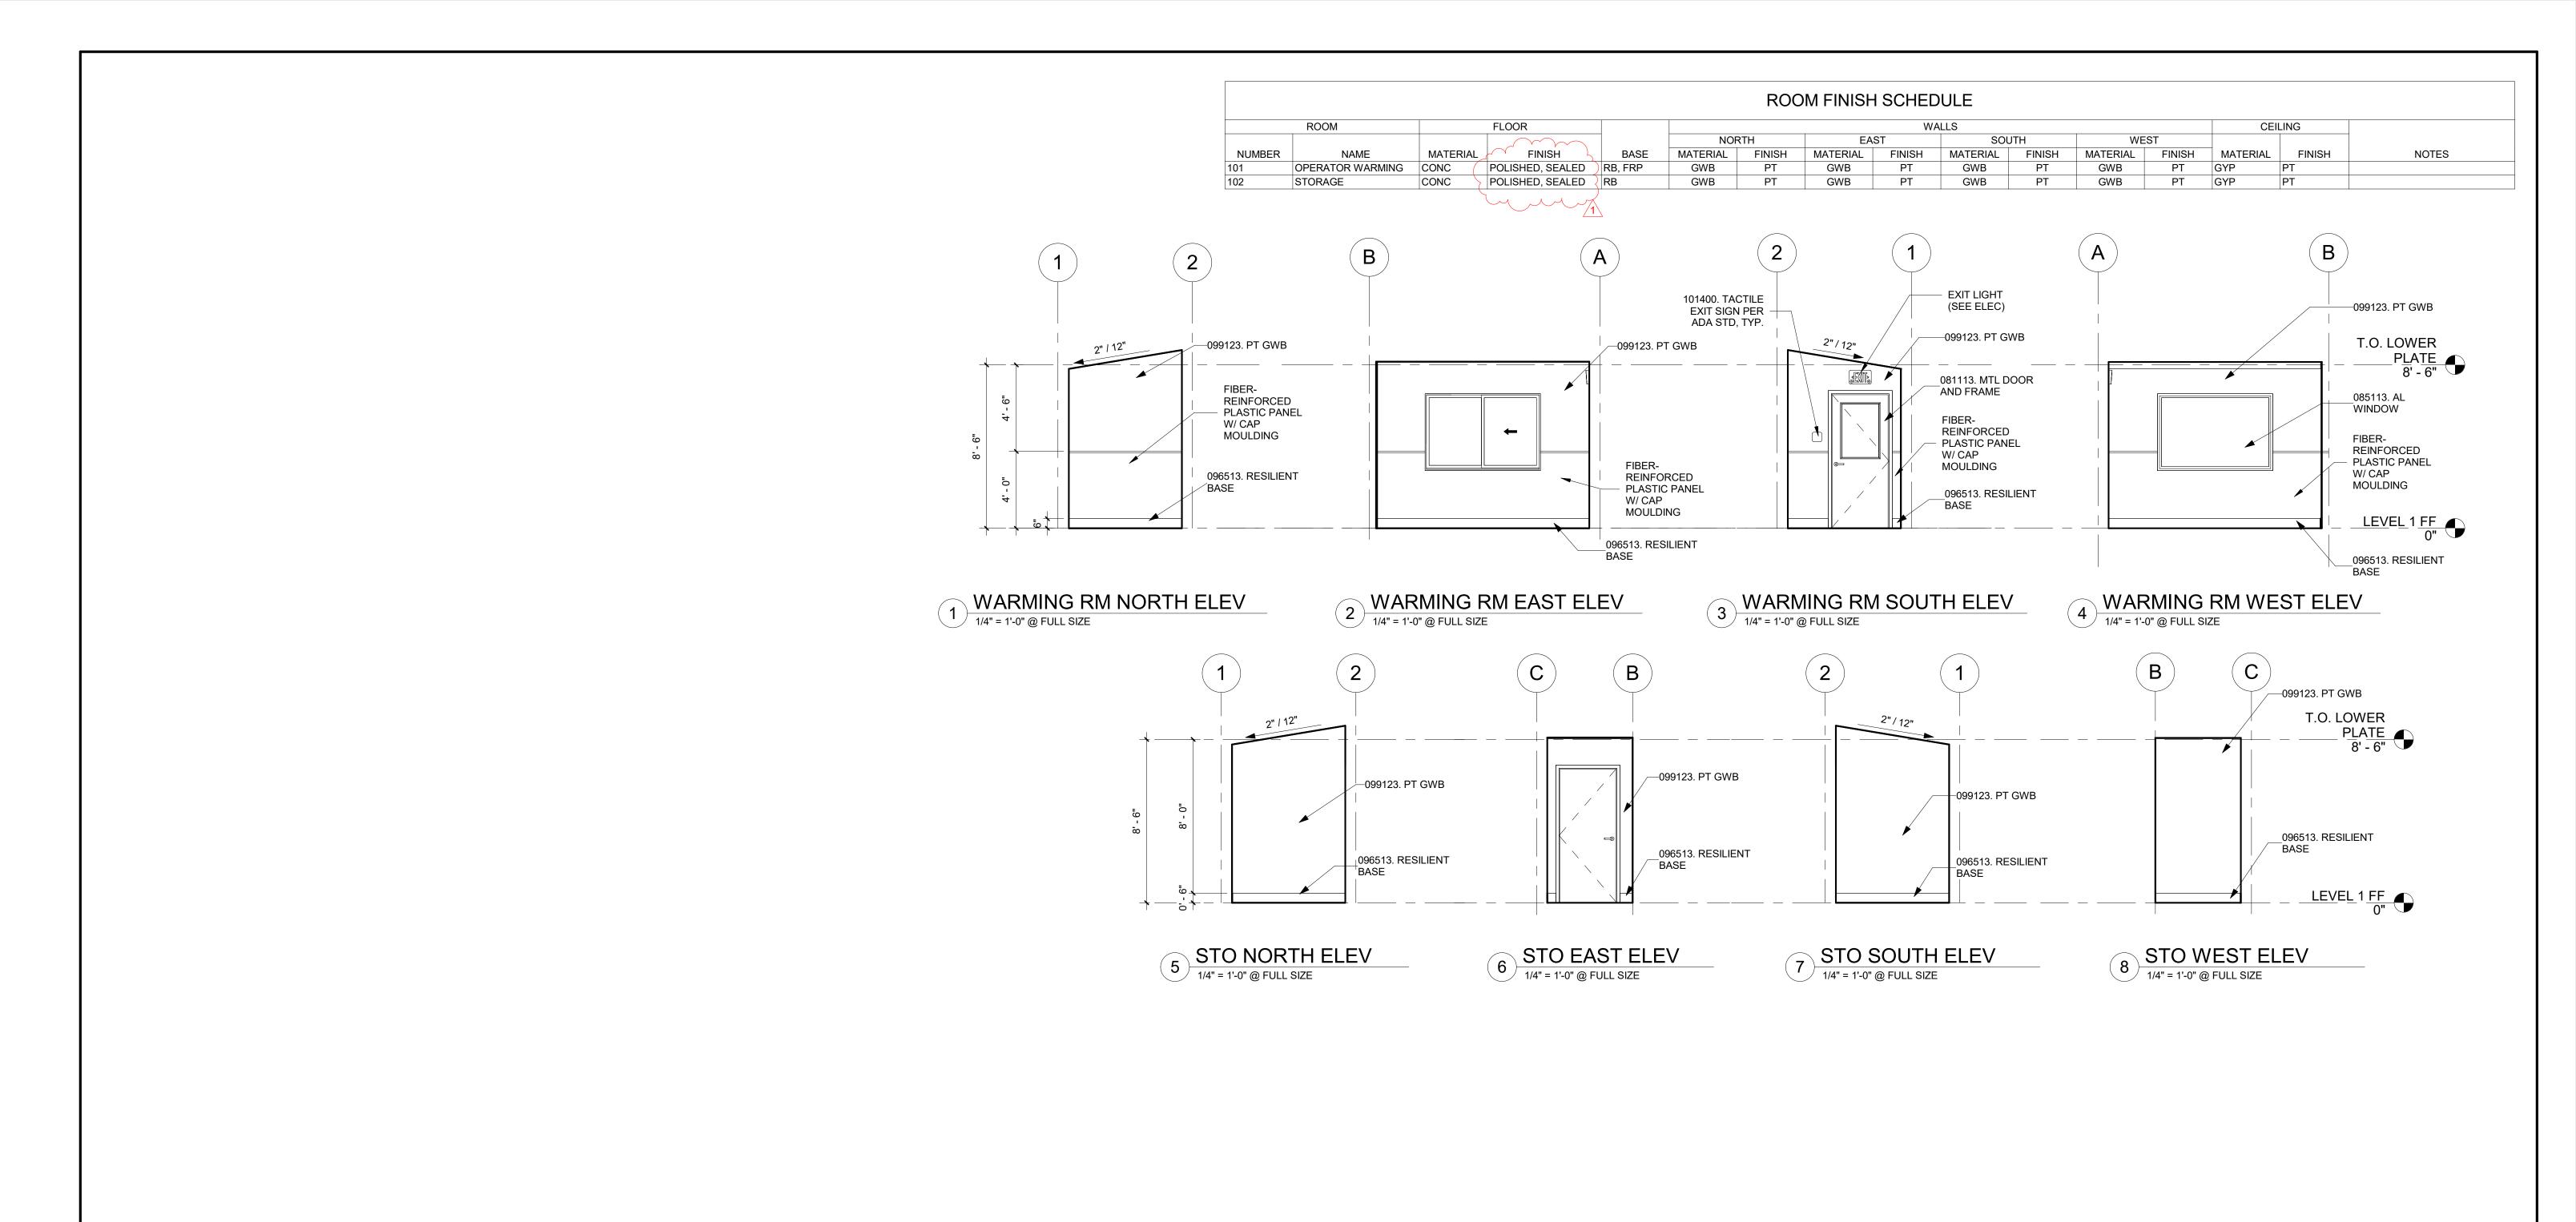

	REVISIONS	DATE	ВҮ	<b>DESIGNED</b> Designer
1	ADDENDUM No. 3	12/7/25		DRAWN
				Author
				CHECKED
				Checker
				APPROVED

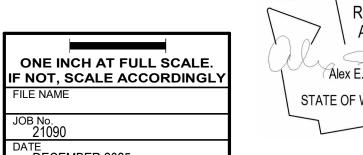

DECEMBER 2025

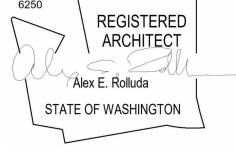





PROJECT NAME


SILVERDALE RECYCLING AND GARBAGE FACILITY
REDEVELOPMENT
KITSAP COUNTY, WASHINGTON

OPERATOR WARMING STATION INTERIOR ELEVATIONS AND FINISH SCHEDULE

DRAWING NO. OF

A50.51

	DOOR & WINDOW MATERIAL & FINISH LEGEND
MATERI	AL KEY
AL	ALUMINUM
ANOD	ANODIZED
НМ	HOLLOW METAL
SS	STAINLESS STEEL
1	INSULATED
Т	TEMPERED
FINISH I	<u>KEY</u>
PC	POWDER COATED
PT	PAINTED

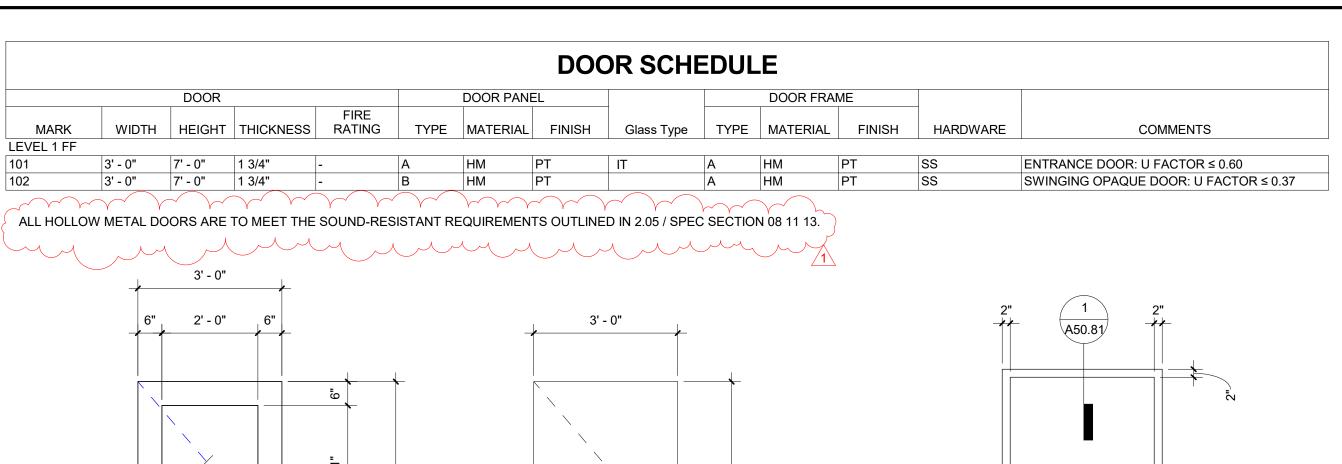

FF


METAL SWING DOOR WITH VISION
GLASS PANEL

B


METAL SWING DOOR

B

METAL SWING DOOR

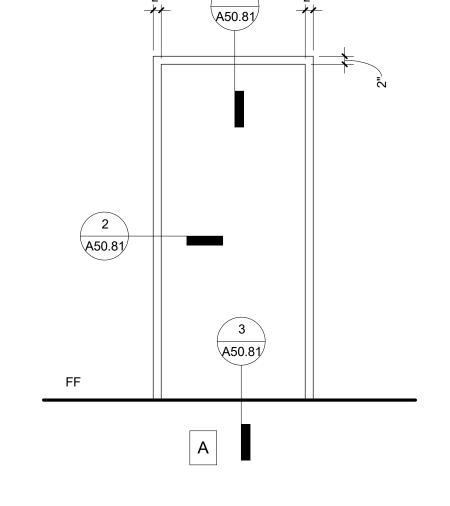




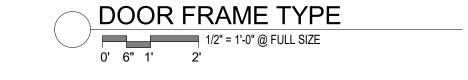

	WINDOW SCHEDULE								
Mark	Туре	Description	Frame Material	Glazing Materia	l Width	Height	Sill Height	Head Height	Comments
					_				
101	Α	FIXED	AL, MFR ANOD	IT	6' - 0"	4' - 0"	3' - 0"	7' - 0"	PROVIDE ROLLER SHADE ON ALL GLASS WINDOWS.
102	В	SLIDING	ALUM, MFR ANOD	IT	6' - 0"	4' - 0"	3' - 0"	7' - 0"	PROVIDE ROLLER SHADE ON ALL GLASS WINDOWS.

ALL INSULATED GLASS UNITS MUST MEET THE FOLLOWING RATINGS: U-FACTOR= 0.36 MAX. SHGC= 0.38 MAX. VT= 0.6

FENESTRATION PRODUCTS SHALL BE LABELED WITH NFRC U-FACTORS, SHGC, VT AND LEAKAGE RATING, OR IF PRODUCTS DO NOT HAVE NFRC RATING, INDICATE APPLICABLE WSEC CHAPTER 3 DEFAULT VALUES

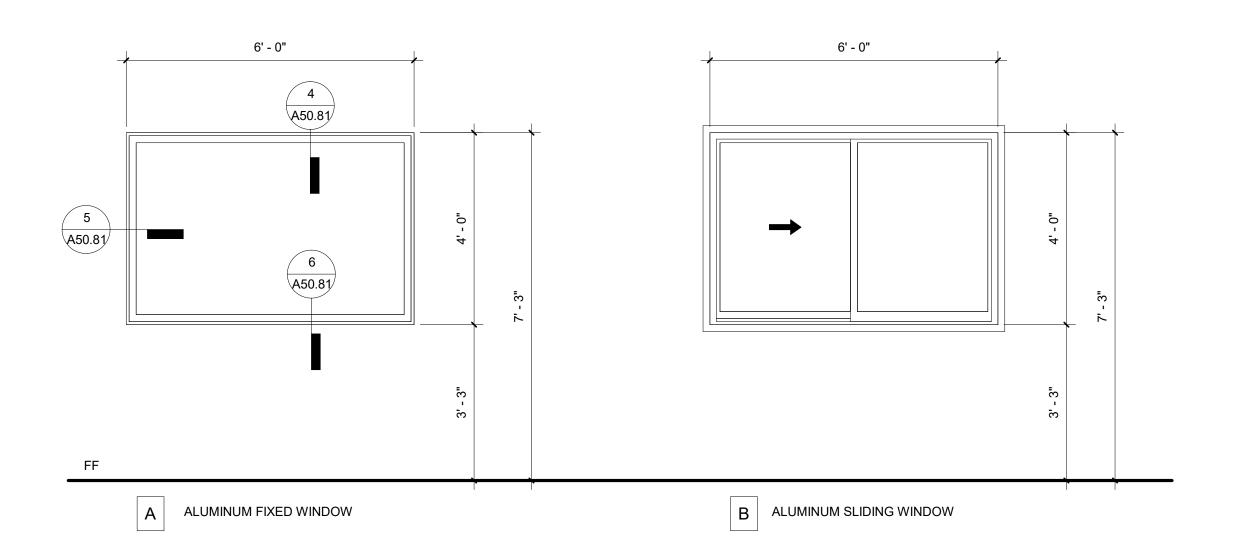




**ISSUE FOR BID** 

	REVISIONS	DATE	ВҮ	<b>DESIGNED</b> Designer
1	ADDENDUM No. 3	12/7/25		DRAWN Author
				CHECKED Checker
				APPROVED Approver

ONE INCH AT FULL SCALE.
IF NOT, SCALE ACCORDINGLY
FILE NAME

JOB No.
21090

DATE
DECEMBER 2025

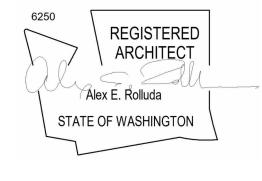






PROJECT NAME

SILVERDALE RECYCLING AND GARBAGE FACILITY
REDEVELOPMENT
KITSAP COUNTY, WASHINGTON

OPERATOR WARMING STATION WINDOW & DOOR TYPES AND SCHEDULES

DRAWING NO.

A50.71

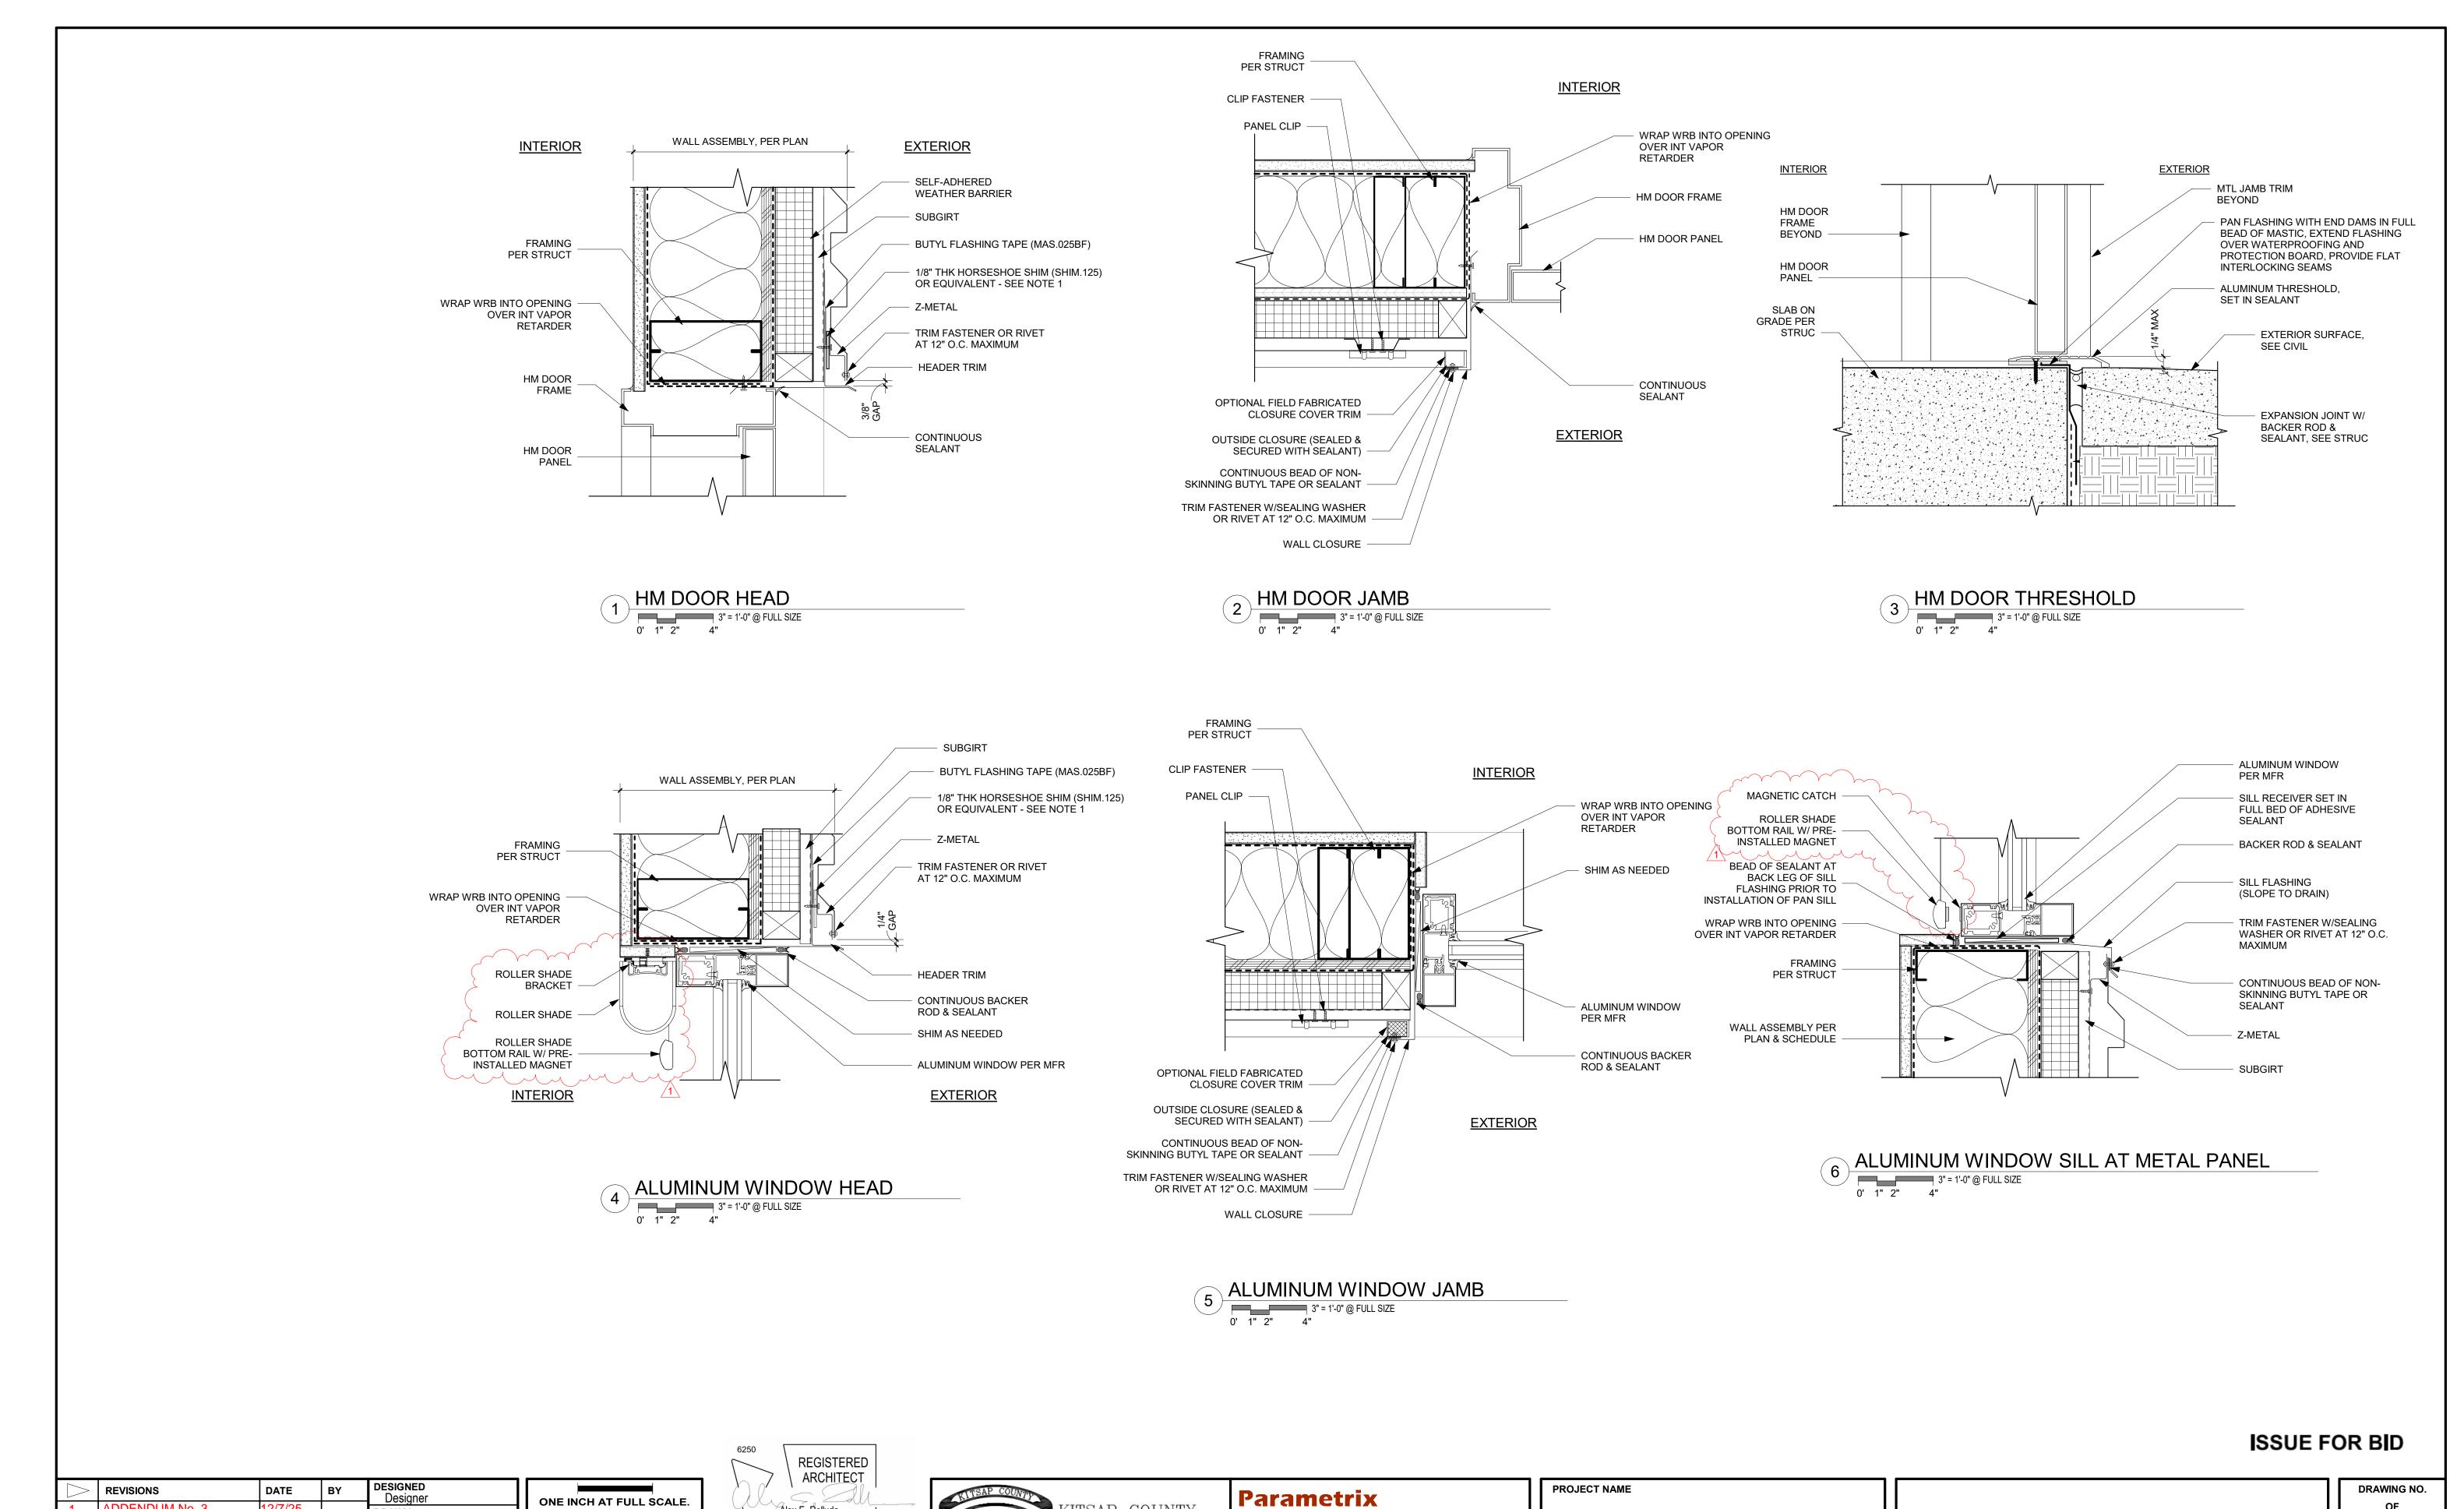

KITSAP COUNTY

614 DIVISION STREET MS-26

PORT ORCHARD, WA 98366

DEPT. OF PUBLIC WORK

TEL:(360) 337-5777 FAX:(360) 337-4867

ENGINEERING . PLANNING . ENVIRONMENTAL SCIENCES

19 SECOND AVENUE SE, SUITE 100 | SEATTLE, WA 98104

206.394.3700

WWW.PARAMETRIX.COM

SILVERDALE RECYCLING AND GARBAGE FACILITY

**REDEVELOPMENT** 

KITSAP COUNTY, WASHINGTON

Alex E. Rolluda

STATE OF WASHINGTON

IF NOT, SCALE ACCORDINGL

DECEMBER 2025

ADDENDUM No. 3

DRAWN

LCG

CHECKED

Checker

APPROVED

Approver

OF **OPERATOR WARMING STATION BUILDING DETAILS** 

A50.81

#### PANELBOARD SCHEDULE

NAME: PBD-AB1

VOLTAGE RATING: 120/240 VOLTS, 1 PHASE, 3 WIRE

BUS RATING: **225A** AMPS MAIN BREAKER: **225A** AMPS FEED: **BOTTOM** 

MOUNTING: SURFACE

SPECIAL FEATURES: 42KAIC

LINE LOADS: **TOTAL LOAD:**  LOCATION: ATTENDANT BLDG - SERVER ROOM

20,070 VA(L2)

FED FROM: **MDP** NOTES: **NEMA 1** 

LOAD TYPE			СКТ	BRKR	L1	L2	BRKR	СКТ		LOAD TYPE
R	RECEPT, SERVER ROOM	360	1	20 / 1	-A-		40 / 2	2	SPD, MOUNTED ADJACENT TO PBD-AB1	
R	RECEPT, SERVER ROOM	360	3	20 / 1		-B-	40 / 2	4	SFD, MOUNTED ADSACENT TO FBD-ABT	
R	RECEPT, SERVER ROOM	540	5	20 / 1	-A-		20 / 2	6	SPARE	
R	RECEPT, HALL	720	7	20 / 1		-B-	20 / 2	8	SPAIL	
R	RECEPT, CONTROL ROOM	360	9	20 / 1	-A-		40 / 2	10	SPARE	
R	RECEPT, CONTROL ROOM - WEST	360	11	20 / 1		-B-	40 / 2	12		
R	RECEPT, CONTROL ROOM - NORTH	360	13	20 / 1	-A-		20 / 2	14	1,340 EWH-1,EWH-1(2),ECH-3,ECH-3(2) RELAYBOX	Н
R	RECEPT, CONTROL ROOM - NORTH	360	15	20 / 1		-B-	20 / 2	16	1,340 EWH-1,EWH-1(2),ECH-3,ECH-3(2) RELAYBOX	Н
R	RECEPT, CONTROL ROOM - NORTH	360	17	20 / 1	-A-		15 / 1	18	SPARE	
R	RECEPT, CONTROL ROOM - NORTH	360	19	20 / 1		-B-	15 / 1	20	SPARE	
R	RECEPT, CONTROL ROOM - EAST	360	21	20 / 1	-A-		15 / 1	22	120 HEATER, STORAGE RM, ECH-1	Н
R	RECEPT, KITCHEN DISH WASHER/UNDERSINK	1,248	23	20 / 1		-B-	15 / 1	24	210 HEATER, RESTROOM, ECH-2	Н
R	RECEPT, KITCHEN COUNTERTOP	360	25	20 / 1	-A-		15 / 1	26	36 EX-FAN, RESTROOM EF-1	Н
R	RECEPT, KITCHEN COUNTERTOP MICROWAVE	1,200	27	20 / 1		-B-	20 / 1	28	1,176 SUPPLY FAN (SF-1) & DAMPER	Н
R	RECEPT, KITCHEN REFRIGERATOR	1,800	29	20 / 1	-A-		15 / 2	30	SPARE	
R	RECEPT, OUTDOORS - NORTH AND EAST	360	31	20 / 1		-B-	3-	32	SPARE	
R	RECEPT, OUTDOORS - SOUTH AND WEST	360	33	20 / 1	-A-		30 / 2	34	2,250 HEATER, WATER, ATTIC (WH-1)	Н
R	RECEPT, MEZZANINE	180	35	20 / 1		-B-	30 / 2	36	2,250 TIEATER, WATER, ATTIC (WII-1)	Н
L	LTG, STORAGE RM, HALL, WORK RM.	343	37	20 / 1	-A-		40 / 2	38	2,880 DUCTLESS HEAT PUMP (HPCU-1/HPIU-1)	Н
L	LTG, SERVER RM & RESTROOM & MEZZANINE	106	39	20 / 1		-B-	40 / 2	40	2,880 POWER INDOOR UNIT THRU OUTDOOR UNIT.	Н
Х	ATTENDANT CALL (MCS-JB1)	319	41	20 / 1	-A-		40 / 2	42	2,640 DUCTLESS AC UNIT (ACCU-1/ACIU-1)	Н
L	LTG, EXIT SIGN	180	43	20 / 1		-B-	40 / 2	44	2,640 POWER INDOOR UNIT THRU OUTDOOR UNIT.	Н
₩\	REGERT, HALLY	~~~~~~~~~~~~~~~~~~~~~~~~~~~~~~~~~~~~~~	<b>45</b> Y	201/1	-A-		35 / 2	46	3,750 DUCT HEATER (DH-1)	Н
X	FIRE ALARM CONTROL PANEL SPARE	<del>-360</del>	47	20 / 1	) 1	-B-	33 / 2	48	3,750 DOCT TIEATER (BH-1)	Н
	GAS DETECTOR/CONTROLLER	<u> </u>	<del>\</del> 49\	20/14	-A-		30 / 2	50	SPARE	
Х	GAS MONITOR RELAY CONTROL PANEL	30	51	20 / 1		-B-	30 / 2	52	OF AINE	
	SPARE		53	20 / 1	-A-		20 / 2	54	SPARE	
	SPARE		55	20 / 1		-B-	20 / 2	56	SFARE	

PBD-AB1 LOAD CALCULATION:					
		CONNECTED VA	<u>METHOD</u>	NEC DEMAND	CALC. VA
TOTAL EXISTING (E) LOAD FROM 30 DAY					
METER RECORDING, PER NEC (2017) 220.87:	E	0	ALL @	125%	0
TOTAL LIGHTING (L) LOAD:	L	629	ALL @	125%	786
TOTAL RECEPTACLE (R) LOAD:	R	10188	FIRST 10KVA @	125%	10000
			REMAINDER OVER 10KVA	50%	94
TOTAL MOTOR (M) LOAD:	M	0	ALL @	100%	0
	LM	0	125% OF LARGEST	125%	0
TOTAL HVAC (H) LOAD:	Н	27262	ALL @	125%	34078
TOTAL MISCELLANEOUS (X) LOAD:	X	733	ALL @	125%	916
TOTAL VA:		38812 VA			45874 VA
AVERAGE AMPS @		162 AMPS			191 AMPS
VOLTAGE PHASE TO PHASE=	2	40			

161.7 AMPS

18,742 VA(L1)

38.81 KVA

PANELBOARD SCHEDULE

NAME: PBD-LH1

VOLTAGE RATING: 120/240 VOLTS, 1 PHASE, 3 WIRE BUS RATING: **150** AMPS

MAIN BREAKER: **150** AMPS FEED: **BOTTOM** 

LOCATION: LHHW BLDG - STORAGE ROOM

FED FROM: **MDP** 

MOUNTING: SURFACE SPECIAL FEATURES: 42KAIC NOTES: NEMA 1

LOAD TYPE	CIRCUIT DESCRIPTION	VA	CKT	BRKR	L1	L2	BRKR	CKT	VA	CIRCUIT DESCRIPTION	LOAD TYPE
R	RECEPT, EXTERIOR	180	1	20 / 1	-A-		20 / 1	2	94	LTG, WARMING ROOM & STORAGE & OUTSIDE	L
R	RECEPT, STORAGE RM	360	3	20 / 1		-B-	20 / 1	4	148	LTG, GARAGE	L
R	RECEPT, COMM CABINET	360	5	20 / 1	-A-		35 / 2	6	3,000	HEATER, WATER (WH-2)	Н
R	RECEPT, WARMING ROOM	360	7	20 / 1		-B-	33 / 2	8	3,000	HEATER, WATER (WH-2)	Н
R	RECEPT, WARMING ROOM	180	9	20 / 1	-A-		20 / 1	10	500	HEATER, WALL (EWH-2)	Н
Х	REMOTE ATTENDANT CALL STATION	480	11	20 / 1		-B-	20 / 1	12	420	HEATER, COVE (ECH-4)	Н
R	RECEPT, GARAGE SOUTH	360	13	20 / 1	-A-		20 / 1	14	210	HEATER, COVE (ECH-1)	Н
R	RECEPT, GARAGE CENTER	360	15	20 / 1		-B-	20 / 1	16		SPARE	
R	RECEPT, GARAGE NORTH	360	17	20 / 1	-A-		20 / 1	18		SPARE	
R	RECEPT,FREEZE PROT. SINK & P-TRAP	72	19	20 / 1		-B-	20 / 1	20		SPARE	
R	RECEPT,FREEZE PROT. EYE WASH	36	21	20 / 1	-A-		20 / 1	22		SPARE	
	SPARE		23	20 / 1		-B-	20 / 1	24		SPARE	
	LINE LOADS:	5,280	VA(L	1)	•	•			5,200	VA(L2)	•
	TOTAL LOAD:	10.48	KVA			43.7	AMPS				

		CONNECTED VA	METHOD NEC DEMAND		CALC. VA
TOTAL EXISTING (E) LOAD FROM 30 DAY					
METER RECORDING, PER NEC (2017) 220.87:	E	0	ALL @	125%	0
TOTAL LIGHTING (L) LOAD:	L	242	ALL @	125%	303
TOTAL RECEPTACLE (R) LOAD:	R	2628	FIRST 10KVA @	125%	3285
			REMAINDER OVER 10KVA	50%	0
TOTAL MOTOR (M) LOAD:	M	0	ALL @	100%	0
	LM	0	125% OF LARGEST	125%	0
ΓΟΤΑL HVAC (H) LOAD:	Н	7130	ALL @	125%	8913
TOTAL MISCELLANEOUS (X) LOAD:	X	480	ALL @	125%	600
TOTAL VA:		10480 VA			13100 VA
AVERAGE AMPS @		44 AMPS			55 AM
VOLTAGE PHASE TO PHASE=		240			

### PANELBOARD SCHEDULE

NAME: PBD-WS1

VOLTAGE RATING: 120/240 VOLTS, 1 PHASE, 3 WIRE

BUS RATING: **225A** AMPS

SPECIAL FEATURES: 42KAIC

MAIN BREAKER: 150 FEED: **BOTTOM** MOUNTING: SURFACE

LOCATION: WARMING STATION NORTH SIDE

FED FROM: MDP NOTES: NEMA 4X (SS), REFUSE SHED LOADS BASED **UPON 240V, 20A LOAD** 

									<u> </u>	-,	
LOAD TYPE	CIRCUIT DESCRIPTION	VA	СКТ	BRKR	L1	L2	BRKR	СКТ	VA	CIRCUIT DESCRIPTION	LOAD TYPE
R	RECEPT, WARMING STATION EXTERIOR	180	1	20 / 1	-A-		30 / 2	2	729	REFUSE SHED A	X
R	RECEPT, WARMING STATION INTERIOR	540	3	20 / 1		-B-	30 / 2	4	729	REFUSE SHED A	X
R	RECEPT, WARMING STATION INTERIOR	540	5	20 / 1	-A-		30 / 2	6	645	REFUSE SHED B	X
R	REMOTE ATTENDANT CALL STATION	480	7	20 / 1		-B-	30 / 2	8	645	REFUSE SHED B	Х
	SPARE		9	20 / 1	-A-		30 / 2	10	729	REFUSE SHED C	X
L	LTG, WARMING STATION EXTERIOR	24	11	20 / 1		-B-	30 / 2	12	729	REPUSE SHED C	X
L	LTG, WARMING STATION INTERIOR	43	13	20 / 1	-A-		30 / 2	14	896	REFUSE SHED D	X
Н	HEATER, WARMING STA. ECH-1 AND ECH-4	630	15	20 / 1		-B-	30 / 2	16	896	REPUSE SHED D	X
Н	HEATER, WARMING STA. EWH-2	500	17	20 / 1	-A-		20 / 2	18		SPARE	
R	IRRIGATION CONTROLLER	600	19	20 / 1		-B-	20 / 2	20		SPARE	
	SPARE		21	20 / 1	-A-		20 / 2	22		SPARE	
	SPARE		23	20 / 1		-B-	20 / 2	24		SPARE	
	SPARE		25	20 / 1	-A-		20 / 1	26		SPARE	
	SPARE		27	20 / 1		-B-	20 / 1	28		SPARE	
	SPARE		29	20 / 1	-A-		20 / 1	30		SPARE	
	SPARE		31	20 / 1		-B-	20 / 1	32		SPARE	
	LINE LOADS:	4,263	VA(L	1)					5,274	VA(L2)	-
	TOTAL LOAD:	9.54	KVA			39.7	AMPS				

		CONNECTED VA	<u>METHOD</u>	NEC DEMAND	CALC. VA
TOTAL EXISTING (E) LOAD FROM 30 DAY					
METER RECORDING, PER NEC (2017) 220.87:	E	0	ALL @	125%	0
TOTAL LIGHTING (L) LOAD:	L	67	ALL @	125%	84
TOTAL RECEPTACLE (R) LOAD:	R	2340	FIRST 10KVA @	125%	2925
			REMAINDER OVER 10KVA	50%	0
TOTAL MOTOR (M) LOAD:	M	0	ALL @	100%	0
	LM	0	125% OF LARGEST	125%	0
TOTAL HVAC (H) LOAD:	Н	1130	ALL @	125%	1413
TOTAL MISCELLANEOUS (X) LOAD:	Χ	6000	ALL @	100%	6000
TOTAL VA:		9537 VA			10421 VA
AVERAGE AMPS @		40 AMPS			43 AMPS
VOLTAGE PHASE TO PHASE=		240			


**ISSUE FOR BID** 

**DESIGNED**R. ROHLER REVISIONS DATE DRAWN J. VONDERAHE CHECKED C. WITTMAN APPROVED K. HUFNAGEL

ONE INCH AT FULL SCALE. IF NOT, SCALE ACCORDINGLY FILE NAME \_PMX\_E\_R20\_NEW.rvt

JOB No. 553-1578-155

DATE MARCH 2025

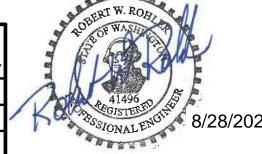



719 SECOND AVENUE SE, SUITE 100 | SEATTLE, WA 98104 P 206.394.3700 WWW.PARAMETRIX.COM


PROJECT NAME

SILVERDALE RECYCLING AND GARBAGE FACILITY REDEVELOPMENT

KITSAP COUNTY, WASHINGTON

**ELECTRICAL SCHEDULES** 

DRAWING NO. 210 **o**F 239

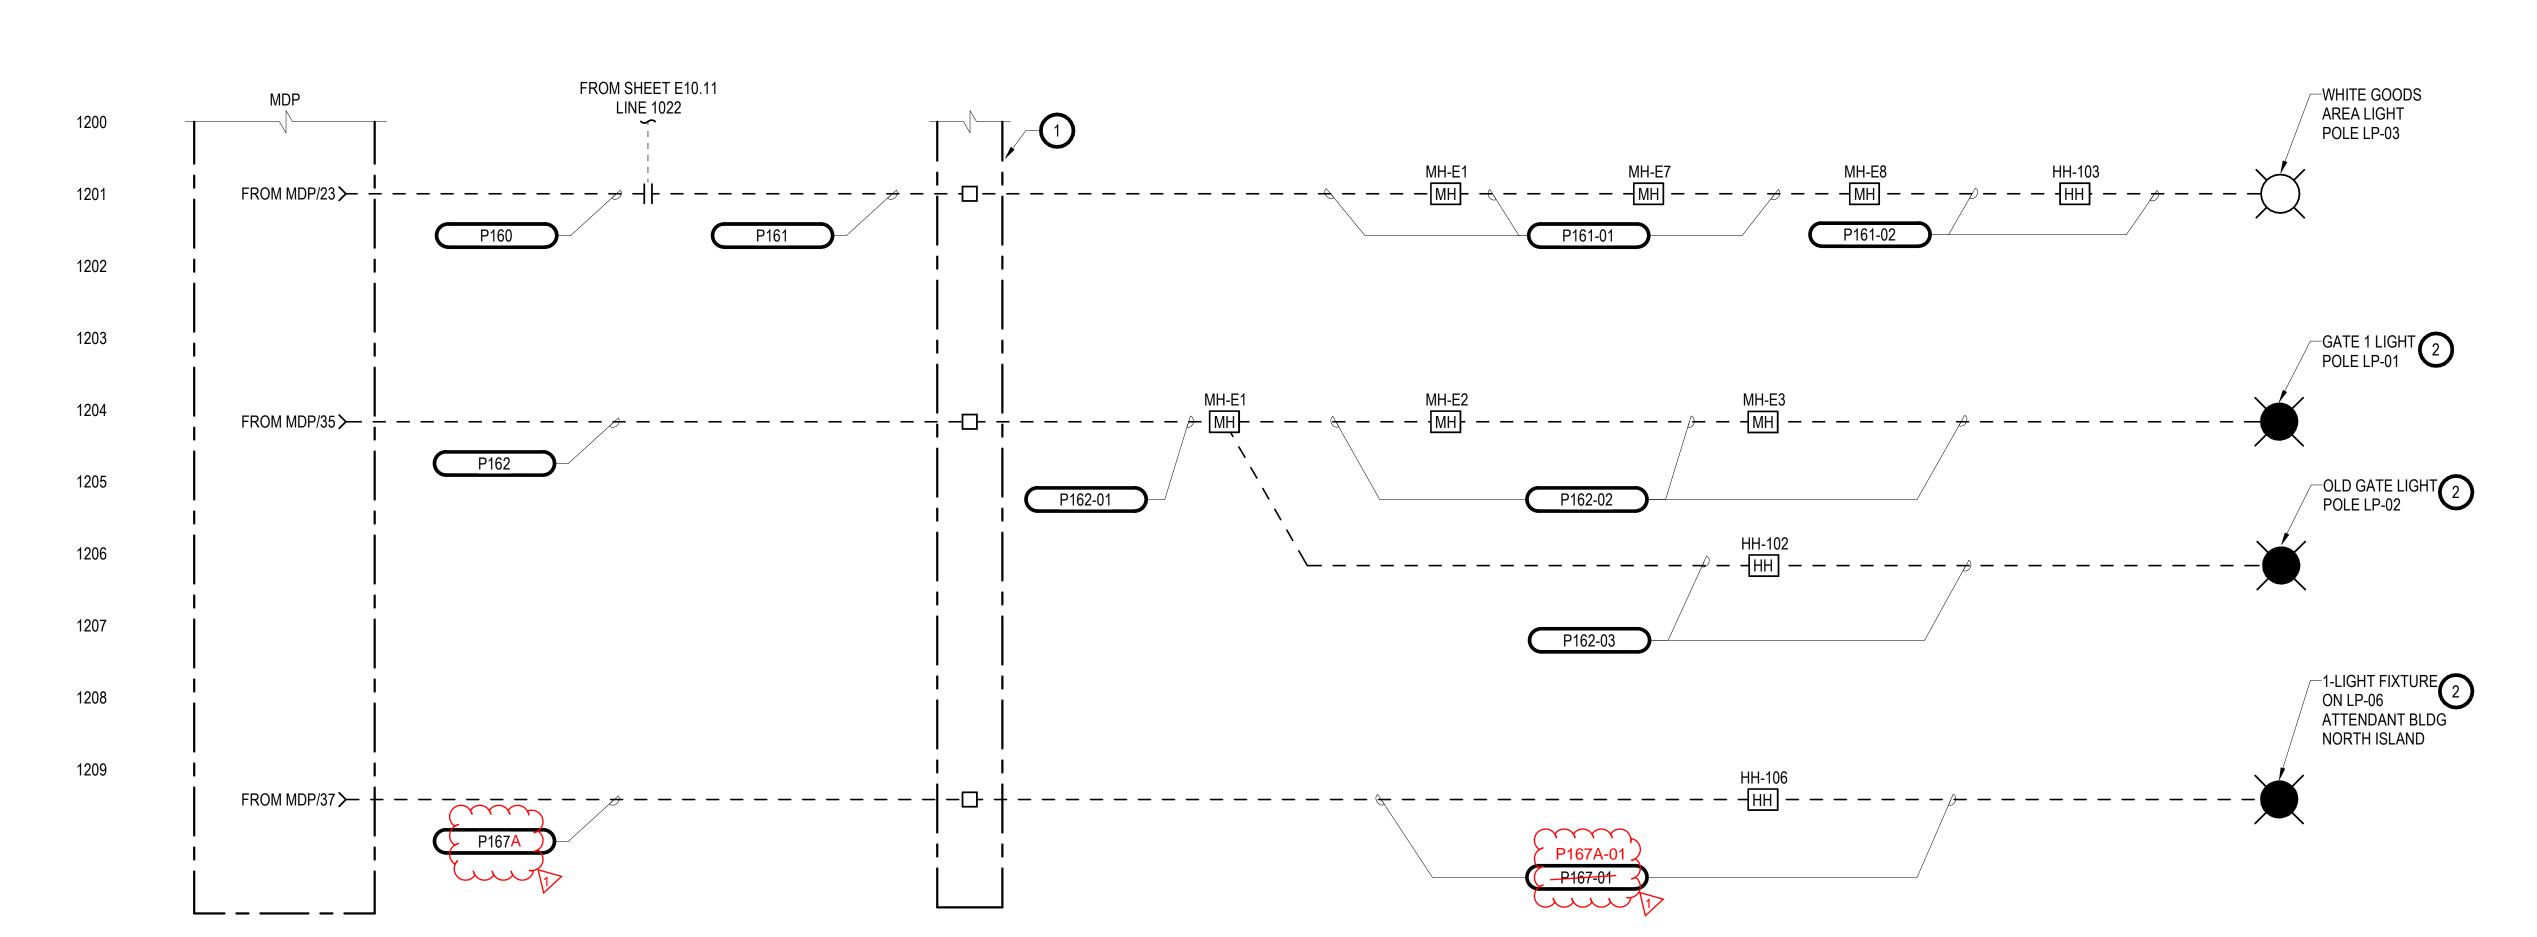

**NOTES:** 

WIRE TROUGH - TERMINAL BOX FOR LARGER CONDUCTORS TO COMPENSATE FOR LONG CIRCUIT LENGTHS.


2 LIGHT FIXTURE IS ON ALL NIGHT, NO LIGHTING CONTACTOR CONTROL. LIGHT FIXTURE HAS ITS OWN PHOTOCELL CONTROL.

LIGHTING CONTROL PANEL LTG-CP1 ELEMENTARY

**DIAGRAM** SCALE: NONE

	REVISIONS	DATE	BY	<b>DESIGNED</b> R. ROHLER
1	ADDENDUM No. 3	12/9/2025	RWR	DRAWN
				J. VONDERAHE
				CHECKED
				C. WITTMAN
				APPROVED
				K. HUFNAGEL

ONE INCH AT FULL SCALE. IF NOT, SCALE ACCORDINGLY FILE NAME \_PMX\_E\_R20\_NEW.rvt JOB No. 553-1578-155 MARCH 2025

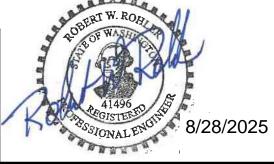



**Parametrix** 719 SECOND AVENUE SE, SUITE 100 | SEATTLE, WA 98104 P 206.394.3700 WWW.PARAMETRIX.COM

PROJECT NAME


SILVERDALE RECYCLING AND GARBAGE FACILITY
REDEVELOPMENT

KITSAP COUNTY, WASHINGTON

**ELECTRICAL SITE LIGHTING CONTROL DIAGRAM LTG-CP1** 

DRAWING NO. 215 **of** 239

**ISSUE FOR BID** 

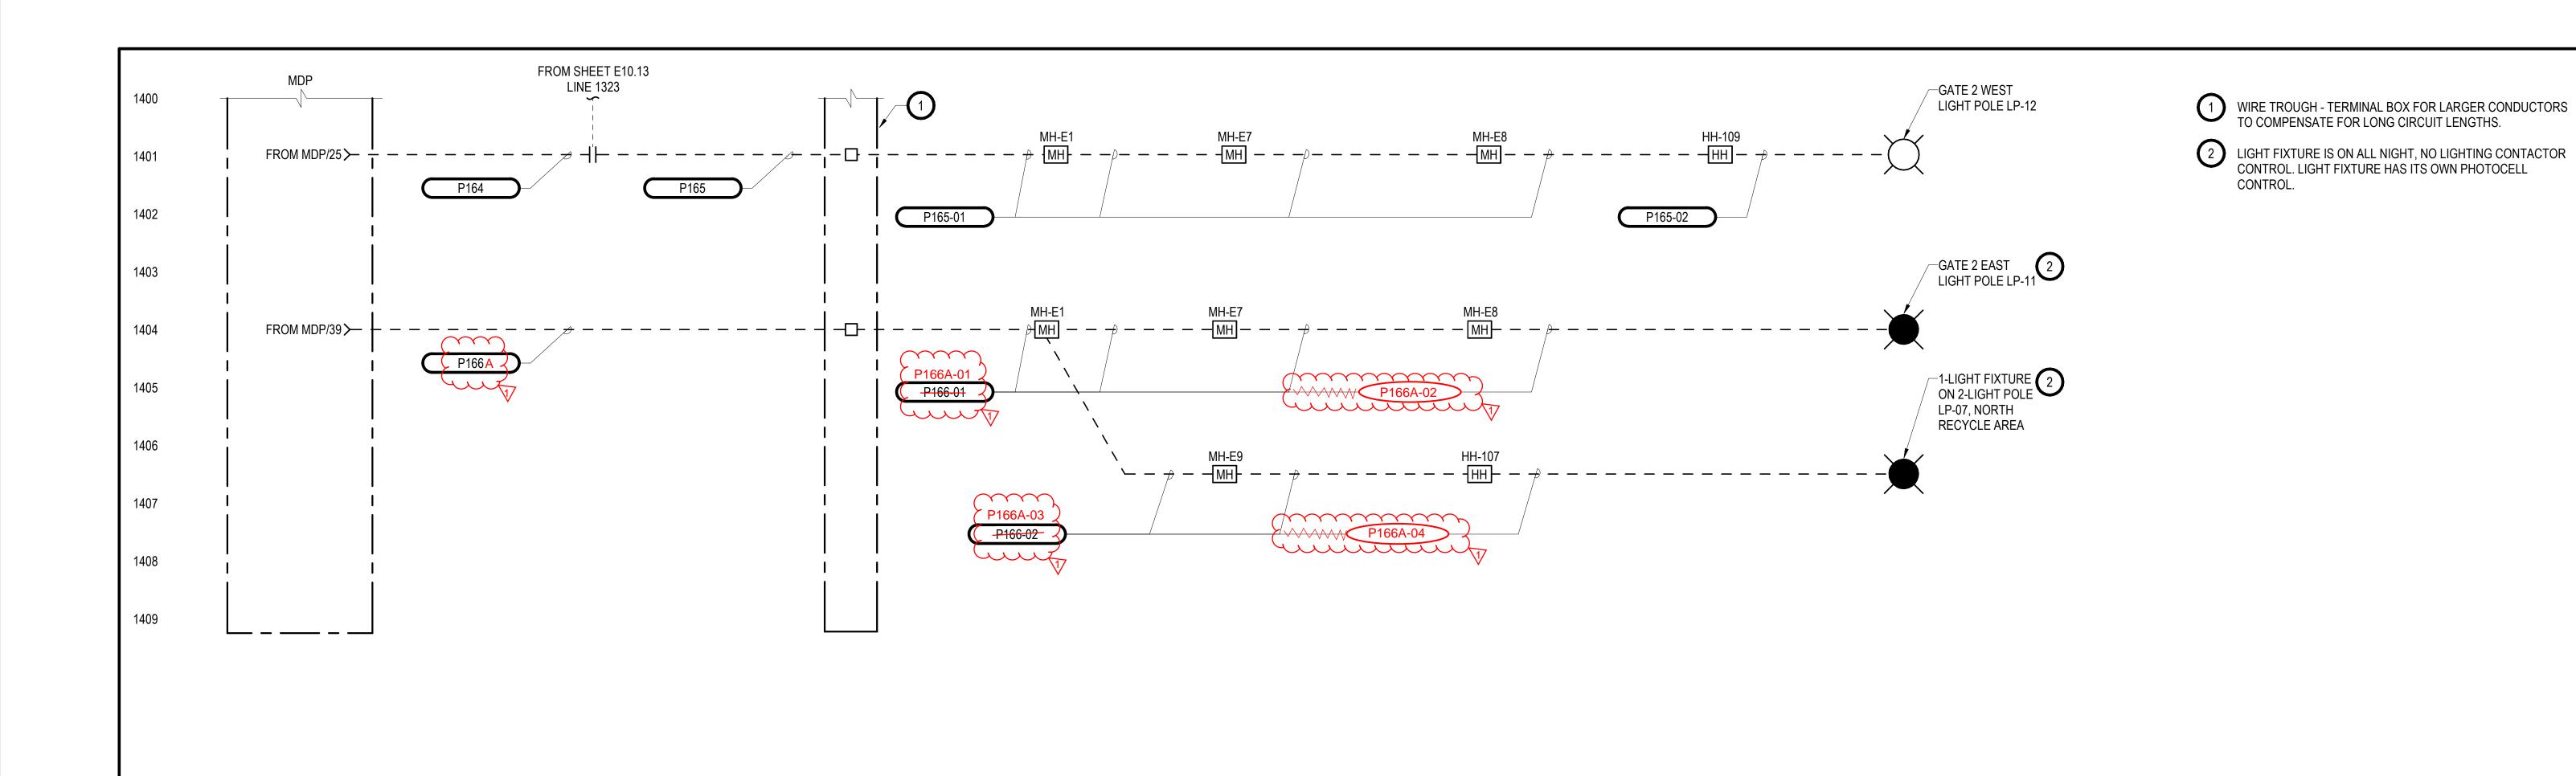

LIGHTING CONTROL PANEL LTG-CP2 ELEMENTARY
DIAGRAM
1

SCALE: NONE

**ISSUE FOR BID** 

REVISIONS

DATE
BY

DESIGNED
R. ROHLER

NR. ROHLER

ONE INCH AT IF NOT, SCALE

FILE NAME
PMX E R20

C. WITTMAN

APPROVED
K. HUFNAGEL

DATE


MARCH 206

ONE INCH AT FULL SCALE.
IF NOT, SCALE ACCORDINGLY

FILE NAME
PMX E R20\_NEW.rvt

JOB No.
553-1578-155

DATE
MARCH 2025

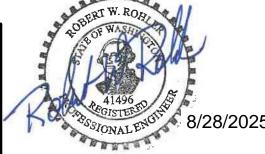



Parametrix
719 SECOND AVENUE SE, SUITE 100 | SEATTLE, WA 98104
P 206.394.3700
WWW.PARAMETRIX.COM

PROJECT NAME

SILVERDALE RECYCLING AND GARBAGE FACILITY REDEVELOPMENT

KITSAP COUNTY, WASHINGTON

ELECTRICAL SITE LIGHTING CONTROL DIAGRAM LTG-CP2

DRAWING NO. 217 OF 239

PIGE   174   PIGE   1868   PULL STRING & INNERDUCT   POCKEY FORM   POC		<b>CONDUIT QTY &amp;</b>	CONDUIT		WIRE				
PROPERTY	UMBER	,		WIRE FILL		FROM	ТО	VIA	REMARKS PROVIDE CONDUIT PER PSE ELECTR
PICOS (1) 4" SPARE POC I RGS PULL STRING POC POCATO	P100	(1) 4"	PVC / RGS	· ·					SERVICE HANDBOOK, PSE TO INSPEC CONDUIT PRIOR TO COVERING, PSE PROVIDED PRIMARY CABLE. PROVID THREADED PLUGS AT EACH END IN T SPARE CONDUIT. PROVIDE BELLEND FOR PSE'S USE ON MEDIUM VOLTAGE CABLE CONDUIT.
C1004	P100A	(1) 4" SPARE	PVC / RGS	PULL STRING					PROVIDE CONDUIT PER PSE ELECTR SERVICE HANDBOOK, PSE TO INSPEC CONDUIT PRIOR TO COVERING, PROVIDE THREADED PLUGS (BOTH ENDS) IN SPARE CONDUIT.
C1000	C100	(1)3"	PVC / RGS	PULL STRING & INNERDUCT		PEDESTAL, DICKEY			RGS WHERE CONDUIT IS EXPOSED, STUBUP CONDUIT 2' AFF AT PLYWOO ID CONDUIT "COMMUNICATIONS."
POLE AT DICKEY   PVC / RGS	C100A	(1)3"	PVC / RGS	PULL STRING & INNERDUCT					SPARE CONDUIT, RGS WHERE COND IS EXPOSED, PROVIDE THREADED PLUGS (BOTH ENDS) IN SPARE CONDUIT. STUBUP CONDUIT 2' AFF A PLYWOOOD. SPARE CONDUIT STOPS AT FENCE LINE. ID CONDUIT "COMMUNICATIONS."
PVC   RGS	C100B	(1)3"	PVC / RGS	PULL STRING & INNERDUCT		RD NW (EAST OF	MH-C1		ALTERNATE COMMUNICATION COND RGS WHERE CONDUIT IS EXPOSED. PROVIDE THREADED PLUGS AT BOTI END OF CONDUIT. MAINTAIN SEPARATION FROM POWER CONDUIT PER PSE ELECTRIC SERVICE HANDBOOK. ID CONDUIT "COMMUNICATIONS."
PP01	0100C	(1).3"	PVC / RGS	PULL STRING & INNERDUCT		MH-C1			SPARE CONDUIT, RGS WHERE CONDUIS EXPOSED, PROVIDE THREADED PLUGS (BOTH ENDS) IN SPARE CONDUIT. STUBUP CONDUIT 2' AFF APLYWOOOD. SPARE CONDUIT STOP AT FENCE LINE.
P102A   (1) 2"   RGS	P101	(2) 3"	PVC / RGS	(2) #250 KCMIL, (1) #250 KCMIL NEU.	XHHW-2	MOUNTED			RGS WHERE CONDUIT IS EXPOSED
PILLS   PUC   RGS	P102	(2) 3"	PVC / RGS	(2) #250 KCMIL, (1) #250 KCMIL NEU, (1)#2/0 G	XHHW-2		SE-DISC		RGS WHERE CONDUIT IS EXPOSED
11   15   PVC   (1) #2/0 GROUND ELECTRODE CONDUCTOR BARE CU   SE-DISC   SROUND ELECTRODE SYSTEM   SERVICE ENTRANCE DISCIDED   SYSTEM   SINCE ENTRANCE DISCIDE   SYSTEM   SINCE ENTRANCE DISCIDE   SYSTEM   SINCE ENTRANCE DISCIDE   SYSTEM   SINCE ENTRANCE DISCIDE   SYSTEM	P102A	(1) 2"	RGS	PULL STRING					PSE TO PROVIDE CT WIRING TO MET BASE / SOCKET
P103 (2) 3" PVC / RGS (2) #250 KCMIL, (1) #250 KCMIL NEU, (1)#2/0 G XHHW-2 SE-DISC ATS-1 RGS WHERE CONDUIT I FOR ATS CONTROLS TO COIL AND STOW SPARE CONDUIT I PVC / RGS (16) #14, (1) #14 G XHHW-2 GEN-1 ATS-1 FOR ATS CONTROLS TO COIL AND STOW SPARE CONDUIT I PVC / RGS PULL STRING GEN-1 ATS-1 RGS WHERE CONDUIT I READED PLOCATION PLOCATION PRATE CONDUIT I READED PLOCATION PLOCATION PRATE CONDUIT I READED PLOCATION PLOCATION PLOCATION PRATE CONDUIT I READED PLOCATION PLOCATION PLOCATION PRATE CONDUIT I READED PLOCATION PLOCATION PRATE CONDUIT I READED PLOCATION PL	P102B	(1) 1.5"	PVC	(1) #2/0 GROUND ELECTRODE CONDUCTOR	BARE CU	SE-DISC			MAIN BONDING JUMP LOCATED IN SERVICE ENTRANCE DISONNECT (S
COIL AND STOW SPARE	P103	(2) 3"	PVC / RGS	(2) #250 KCMIL, (1) #250 KCMIL NEU, (1)#2/0 G	XHHW-2	SE-DISC	ATS-1		RGS WHERE CONDUIT IS EXPOSED
PVC / RGS	C103	(1) 1"	PVC / RGS	(16) #14, (1) #14 G	XHHW-2	GEN-1	ATS-1		FOR ATS CONTROLS TO GENERATO COIL AND STOW SPARE WIRING.
P104 (2) 3" PVC / RGS (2) #250 KCMIL, (1) #250 KCMIL NEU, (1)#2/0 G XHHW-2 GEN-1 ATS-1 RGS WHERE CONDUIT I ROUGH (1)1" PVC / RGS PULL STRING PVC / RGS (2) #250 KCMIL, (1) #250 KCMIL NEU, (1)#2/0 G XHHW-2 ATS-1 SRV-1, SEE DRAWING FOR LOCATION ENDS) IN SPARE CONDUIT I ROUGH ENDS) IN SPARE CONDUIT I ROUGH ENDS (2) #250 KCMIL, (1) #250	103A	(1) 1"	PVC / RGS	PULL STRING		GEN-1	,		PROVIDE THREADED PLUGS (BOTH ENDS) IN SPARE CONDUIT.
Policy   P	P104	(2) 3"	PVC / RGS	(2) #250 KCMIL, (1) #250 KCMIL NEU, (1)#2/0 G	XHHW-2	GEN-1	ATS-1		RGS WHERE CONDUIT IS EXPOSED
CONTROL WRING FOR LOCATED IN ATTENDAN LIGHTING CONTROL PAISTOWN SPARE WIRING.  CONTROL WRING FOR LOCATED IN ATTENDAN LIGHTING CONTROL PAISTOW SPARE WIRING.  CONDUIT MAYBE SHARE MULTIPLE BRANCH CIRE CONDUIT LENGTH IS CONDUIT LENGTH IS CONDUIT IS EXPOSED.  CONDUIT MAYBE SHARE MULTIPLE BRANCH CIRE CONDUIT IS EXPOSED.  CONDUIT MAYBE SHARE MULTIPLE BRANCH CIRE CONDUIT IS EXPOSED.  CONDUIT MAYBE SHARE MULTIPLE BRANCH CIRE CONDUIT IS EXPOSED.  CONDUIT MAYBE SHARE MULTIPLE BRANCH CIRE CONDUIT LENGTH IS CONDUIT LENGTH IN LENGTH IS CONDUIT LENGTH IS CONDUIT LENGTH IS CONDUIT LENGTH IN LE	C104	(1)1"	PVC / RGS	PULL STRING		ATS-1			PROVIDE THREADED PLUGS (BOTH ENDS) IN SPARE CONDUIT.
P140 (1)3" RGS (1)#12, (1)#12NEU, (1)#12G XHHW-2 MDP LTG-CP2 MULTIPLE BRANCH CIRC CONDUIT LENGTH IS CONDUIT LENGTH IS CONDUIT IS EXPOSED.  P141 (1)3" RGS (1)#12, (1)#12NEU, (1)#12G XHHW-2 LTG-CP2 WIRE TROUGH  CONDUIT MAYBE SHARE MULTIPLE BRANCH CIRC CONDUIT LENGTH IS CONDUIT LENGTH IN CONDUIT LENGTH IS CONDUIT LENGTH IN CONDUIT LENGTH IS CONDUIT LENGTH IN CONDUIT LENGTH							LTG-HS	LTG-CP2	RGS WHERE CONDUIT IS EXPOSED  CONTROL WIRING FOR LTG-HS LOCATED IN ATTENDANT BUILDING LIGHTING CONTROL PANELS. COIL STOW SPARE WIRING.
P141 (1)3" RGS (1)#12, (1)#12NEU, (1)#12G XHHW-2 LTG-CP2 WIRE TROUGH MULTIPLE BRANCH CIRC CONDUIT LENGTH IS CONDUIT LENGTH IS CONDUIT IS EXPOSED.	P140	(1)3"	RGS	(1)#12, (1)#12NEU, (1)#12G	XHHW-2	MDP	LTG-CP2		CONDUIT MAYBE SHARED WITH MULTIPLE BRANCH CIRCUITS IF CONDUIT LENGTH IS COMPLIANT WI NEC 310.15(C)(1)(b), REFUSE SHED EXTERIOR LIGHTING, RGS WHERE
		, ,							CONDUIT MAYBE SHARED WITH MULTIPLE BRANCH CIRCUITS IF CONDUIT LENGTH IS COMPLIANT WI NEC 310.15(C)(1)(b), REFUSE SHED EXTERIOR LIGHTING, RGS WHERE CONDUIT IS EXPOSED
					, , , , ,		ATTENDANT BLDG	, , , , ,	STUB UP CONDUIT INTO ATTENDANT SERVER ROOM, SEE DWG E30.01.

				CONDUIT A	ND CABLE SCH	EDULE		v2.0
NUMBER	CONDUIT QTY & SIZE	CONDUIT TYPE	WIRE FILL	WIRE TYPE	FROM	ТО	VIA	REMARKS
P141-01	(1)2"	PVC/RGS	(1)#3, (1)#3NEU, (1)#3G	XHHW-2	WIRE TROUGH	MH-E5	MH-E1	LARGER CONDUCTOR DUE TO LONG CIRCUIT LENGTH VOLTAGE DROP, SITE LIGHTING FOR REFUSE SHEDS
P141-02	(1)2"	PVC/RGS	(1)#3, (1)#3NEU, (1)#3G	XHHW-2	MH-E5	JBOX-RSB		SPLICE INTO P141-01 IN MANHOLE, LARGER CONDUCTOR DUE TO LONG CIRCUIT LENGTH VOLTAGE DROP, RGS WHERE CONDUIT IS EXPOSED, SITE LIGHTING FOR REFUSE SHED
P141-03	(1)1"	PVC/RGS	(1)#10, (1)#10NEU, (1)#10G	XHHW-2	JBOX-RSB	EXTERIOR LIGHTING REFUSE SHED B		SPLICE INTO P141-01 IN MANHOLE,
P141-04	(1)2"	PVC/RGS	(1)#3, (1)#3NEU, (1)#3G	XHHW-2	MH-E5	JBOX-RSD		LARGER CONDUCTOR DUE TO LONG CIRCUIT LENGTH VOLTAGE DROP, RGS WHERE CONDUIT IS EXPOSED, SITE LIGHTING FOR REFUSE SHED
P141-05	(1)1"	PVC/RGS	(1)#10, (1)#10NEU, (1)#10G	XHHW-2	JBOX-RSD	EXTERIOR LIGHTING REFUSE SHED D		
P150	(1)3"	RGS	(1)#12, (1)#12NEU, (1)#12G	XHHW-2	MDP	LTG-CP1		CONDUIT MAYBE SHARED WITH MULTIPLE BRANCH CIRCUITS IF CONDUIT LENGTH IS COMPLIANT WITH NEC 310.15(C)(1)(b), SITE LTG LP-13, LP-14, AND LP-15
P151	(1)3"	RGS	(1)#12, (1)#12NEU, (1)#12G	XHHW-2	LTG-CP1	WIRE TROUGH		CONDUIT MAYBE SHARED WITH MULTIPLE BRANCH CIRCUITS IF CONDUIT LENGTH IS COMPLIANT WITH NEC 310.15(C)(1)(b), SITE LTG LP-13, LP-14, AND LP-15
P151-01	(1)3"	PVC/RGS	(1)#4, (1)#4NEU, (1)#4G	XHHW-2	WIRE TROUGH	MH-E5	MH-E1,	LARGER CONDUCTOR DUE TO LONG CIRCUIT LENGTH VOLTAGE DROP, SITE LIGHTING, RGS WHERE CONDUIT IS EXPOSED, SITE LTG LP-13, LP-14, AND LP-15
P151-02	(1)1"	PVC	(1)#10, (1)#10NEU, (1)#10G	XHHW-2	MH-E5	LP-13	HH-113	SPLICE IN MH-E5 TO P151-01, LARGER CONDUCTOR DUE TO LONG CIRCUIT LENGTH VOLTAGE DROP, SITE LIGHTING, SITE LTG
P151-03	(1)1"	PVC	(1)#10, (1)#10NEU, (1)#10G	XHHW-2	MH-E5	LP-14	HH-114	SPLICE IN MH-E5 TO P151-01, LARGER CONDUCTOR DUE TO LONG CIRCUIT LENGTH VOLTAGE DROP, SITE LIGHTING, SITE LTG
P151-04	(1)1"	PVC/RGS	(1)#10, (1)#10NEU, (1)#10G	XHHW-2	MH-E5	LP-15	HH-115	SPLICE IN MH-E5 TO P151-01, LARGER CONDUCTOR DUE TO LONG CIRCUIT LENGTH VOLTAGE DROP, SITE LIGHTING, SITE LTG, RGS WHERE CONDUIT IS EXPOSED.
C151-01	(1)3"	PVC	PULL STRING		COMM-WS1	MH-C5		PROVIDE THREADED PLUGS (BOTH ENDS) IN SPARE CONDUIT.
C151-02	(1)1"	PVC	PULL STRING		MH-C5	HH-115		PROVIDE THREADED PLUGS (BOTH ENDS) IN SPARE CONDUIT.
C151-03	(1)1"	PVC/RGS	PULL STRING		HH-115	LP-15		PROVIDE THREADED PLUGS (BOTH ENDS) IN SPARE CONDUIT, RGS WHERE CONDUIT IS EXPOSED.
C151-04	(1)1"	PVC	PULL STRING		MH-C5	HH-114		PROVIDE THREADED PLUGS (BOTH ENDS) IN SPARE CONDUIT.
C151-05	(1)1"	PVC/RGS	PULL STRING		HH-114	LP=14		PROVIDE THREADED PLUGS (BOTH ENDS) IN SPARE CONDUIT, RGS WHERE CONDUIT IS EXPOSED.
C151-06	(1)1"	PVC	PULL STRING		MH-C5	HH-113		PROVIDE THREADED PLUGS (BOTH ENDS) IN SPARE CONDUIT.
C151-07	(1)1"	PVC/RGS	PULL STRING		HH-113	LP-13		PROVIDE THREADED PLUGS (BOTH ENDS) IN SPARE CONDUIT, RGS WHERE CONDUIT IS EXPOSED.
P152	(1)3"	PVC/RGS	(1)#12, (1)#12NEU, (1)#12G	XHHW-2	MDP	LTG-CP1		CONDUIT MAYBE SHARED WITH MULTIPLE BRANCH CIRCUITS IF CONDUIT LENGTH IS COMPLIANT WITH NEC 310.15(C)(1)(b), ATTENDANT BUILDING EXTERIOR LIGHTING, RGS WHERE CONDUIT IS EXPOSED.

DESIGNED
R. ROHLER
DRAWN
J. VONDERAHE REVISIONS DATE CHECKED C. WITTMAN **APPROVED**K. HUFNAGEL

ONE INCH AT FULL SCALE. IF NOT, SCALE ACCORDINGLY FILE NAME \_PMX\_E\_R20\_NEW.rvt JOB No. 553-1578-155 DATE MARCH 2025

KITSAP COUNTY
DEPT. OF PUBLIC WORKS
614 DIVISION STREET MS-26
PORT ORCHARD, WA 98366
TEL:(360) 337-5777 FAX:(360) 337-4867

Parametrix
719 SECOND AVENUE SE, SUITE 100 | SEATTLE, WA 98104 P 206.394.3700 WWW.PARAMETRIX.COM

PROJECT NAME

SILVERDALE RECYCLING AND GARBAGE FACILITY REDEVELOPMENT

KITSAP COUNTY, WASHINGTON

ELECTRICAL CONDUIT AND CABLE SCHEDULE 1

DRAWING NO. 221 **o**F 239

C162-01 C162-02 C162-03 C162-04 C162-05 P163 P163-01 P163-02 P163-04	(1)3" (1)2" (1)1" (1)1" (1)1" (1)1" (1)1" (1)1"	PVC/RGS PVC PVC/RGS PVC PVC PVC/RGS PVC PVC/RGS	WIRE FILL  PULL STRING & INNERDUCT  PULL STRING  PULL STRING  PULL STRING  PULL STRING  PULL STRING  (1)#12, (1)#12NEU, (1)#12G  (1)#10, (1)#10NEU, (1)#10G	WIRE TYPE	FROM SRV-1, SEE DRAWING FOR LOCATION  MH-C1  MH-C2  MH-C3  MH-C1  HH-102  MDP	TO  MH-C1  MH-C3  LP-01  HH-C3A  HH-102	VIA MH-C2	REMARKS  PROVIDE THREADED PLUGS (BOTH ENDS) IN SPARE CONDUIT, RGS WHERE CONDUIT IS EXPOSED.  PROVIDE THREADED PLUGS (BOTH ENDS) IN SPARE CONDUIT  PROVIDE THREADED PLUGS (BOTH ENDS) IN SPARE CONDUIT, RGS WHERE CONDUIT IS EXPOSED.  PROVIDE THREADED PLUGS (BOTH ENDS) IN SPARE CONDUIT  PROVIDE THREADED PLUGS (BOTH ENDS) IN SPARE CONDUIT  PROVIDE THREADED PLUGS (BOTH ENDS) IN SPARE CONDUIT
C162-01 C162-02 C162-03 C162-04 C162-05 P163 P163-01 P163-02 P163-03 P163-04	(1)2" (1)1" (1)1" (1)1" (1)1"	PVC PVC/RGS PVC PVC PVC/RGS RGS	PULL STRING & INNERDUCT  PULL STRING  PULL STRING  PULL STRING  PULL STRING  (1)#12, (1)#12NEU, (1)#12G		MH-C1 MH-C2 MH-C3 MH-C1 HH-102	MH-C3 LP-01 HH-C3A HH-102	MH-C2	ENDS) IN SPARE CONDUIT, RGS WHERE CONDUIT IS EXPOSED.  PROVIDE THREADED PLUGS (BOTH ENDS) IN SPARE CONDUIT  PROVIDE THREADED PLUGS (BOTH ENDS) IN SPARE CONDUIT, RGS WHERE CONDUIT IS EXPOSED.  PROVIDE THREADED PLUGS (BOTH ENDS) IN SPARE CONDUIT  PROVIDE THREADED PLUGS (BOTH ENDS) IN SPARE CONDUIT
C162-02  C162-03  C162-04  C162-05  P163  P163-01  P163-02  P163-03	(1)1" (1)1" (1)1" (1)1" (1)1"	PVC/RGS PVC PVC PVC/RGS RGS	PULL STRING  PULL STRING  PULL STRING  PULL STRING  (1)#12, (1)#12NEU, (1)#12G	XHHW-2	MH-C2 MH-C3 MH-C1 HH-102	LP-01 HH-C3A HH-102	MH-C2	ENDS) IN SPARE CONDUIT  PROVIDE THREADED PLUGS (BOTH ENDS) IN SPARE CONDUIT, RGS WHERE CONDUIT IS EXPOSED.  PROVIDE THREADED PLUGS (BOTH ENDS) IN SPARE CONDUIT  PROVIDE THREADED PLUGS (BOTH ENDS) IN SPARE CONDUIT
C162-03 C162-04 C162-05 P163 P163-01 P163-02 P163-03	(1)1" (1)1" (1)1" (1)1"	PVC PVC/RGS RGS	PULL STRING  PULL STRING  PULL STRING  (1)#12, (1)#12NEU, (1)#12G	XHHW-2	MH-C3 MH-C1 HH-102	HH-C3A HH-102		ENDS) IN SPARE CONDUIT, RGS WHERE CONDUIT IS EXPOSED.  PROVIDE THREADED PLUGS (BOTH ENDS) IN SPARE CONDUIT  PROVIDE THREADED PLUGS (BOTH ENDS) IN SPARE CONDUIT
C162-04  C162-05  P163  P163-01  P163-02  P163-03	(1)1" (1)1" (1)1"	PVC PVC/RGS RGS	PULL STRING  PULL STRING  (1)#12, (1)#12NEU, (1)#12G	XHHW-2	MH-C1 HH-102	HH-102		ENDS) IN SPARE CONDUIT  PROVIDE THREADED PLUGS (BOTH ENDS) IN SPARE CONDUIT
P163-01 P163-02 P163-03 P163-04	(1)1" (1)1"	PVC/RGS RGS	PULL STRING (1)#12, (1)#12NEU, (1)#12G	XHHW-2	HH-102			ENDS) IN SPARE CONDUIT
P163-01 P163-02 P163-03 P163-04	(1)1"	RGS	(1)#12, (1)#12NEU, (1)#12G	XHHW-2		LP-02		PROVIDE THREADED PLUGS (BOTH
P163-01 P163-02 P163-03	(1)1"			XHHW-2	MUD			ENDS) IN SPARE CONDUIT, RGS WHERE CONDUIT IS EXPOSED.
P163-02 P163-03 P163-04	,	PVC/RGS	(1)#10, (1)#10NEU, (1)#10G		IVIDI	WIRE TROUGH		
P163-03	(1)1"			XHHW-2	WIRE TROUGH	MH-E8	MH-E1, MH-E7	SPLICE TO P163 IN WIRE TROUGH, LARGER CONDUCTOR DUE TO LONG CIRCUIT LENGTH VOLTAGE DROP, SITE LIGHTING FOR GATE 2, RGS WHERE EXPOSED
P163-04		PVC/RGS	(1)#12, (1)#12NEU, (1)#12G	XHHW-2	MH-E8	LP-11		SPLICE TO P163-01 IN MH-E8, SITE LIGHTING FOR GATE 2, RGS WHERE EXPOSED
	(1)1"	PVC/RGS	(4)#12, (1)#12G	XHHW-2	LTG-CP2	WIRE TROUGH		LTG-HSG2 CONTROL WIRING BETWEEN MOMENTARY PUSH BUTTON AND LTG-CP2, COIL AND STOW SPARE WIRING.
	(1)1"	PVC/RGS	(4)#12, (1)#12G	XHHW-2	WIRE TROUGH	JBOX-G2	MH-E1, MH-E7, MH-E8	LTG-HSG2 CONTROL WIRING BETWEEN MOMENTARY PUSH BUTTON AND LTG- CP2
P163-05	(1)1"	PVC/RGS	(4)#12, (1)#12G	XHHW-2	JBOX-G2	LTG-HSG2		LTG-HSG2 CONTROL WIRING BETWEEN MOMENTARY PUSH BUTTON AND LTG-CP2, COIL AND STOW SPARE WIRING.
C163	(1)3"	PVC/RGS	PULL STRING & INNERDUCT		SRV-1, SEE DRAWING FOR LOCATION	MH-C1		PROVIDE THREADED PLUGS (BOTH ENDS) IN SPARE CONDUIT, RGS WHERE CONDUIT IS EXPOSED.
C163-01	(1)2"	PVC	PULL STRING & INNERDUCT		MH-C1	MH-C8	MH-C7	PROVIDE THREADED PLUGS (BOTH ENDS) IN SPARE CONDUIT
C163-02	(1)1"	PVC/RGS	PULL STRING		MH-C8	LP-11		PROVIDE THREADED PLUGS (BOTH ENDS) IN SPARE CONDUIT, RGS WHERE CONDUIT IS EXPOSED.
C163-03	(1)1"	PVC/RGS	PULL STRING		MH-C8	LP-03	HH-103	PROVIDE THREADED PLUGS (BOTH ENDS) IN SPARE CONDUIT, RGS WHERE CONDUIT IS EXPOSED.
C163-04	(1)1"	PVC	PULL STRING		MH-C8	HH-112		PROVIDE THREADED PLUGS (BOTH ENDS) IN SPARE CONDUIT
C163-05	(1)1"	PVC/RGS	PULL STRING		HH-112	LP-12		PROVIDE THREADED PLUGS (BOTH ENDS) IN SPARE CONDUIT, RGS WHERE CONDUIT IS EXPOSED.
P164	(1)3"	RGS	(1)#12, (1)#12NEU, (1)#12G	XHHW-2	MDP	LTG-CP2		CONDUIT IS SHARED WITH MULTIPLE BRANCH CIRCUITS IF CONDUIT LENGTH IS COMPLIANT WITH NEC 310.15(C)(1)(b)
P165	(1)3"	RGS	(1)#12, (1)#12NEU, (1)#12G	XHHW-2	LTG-CP2	WIRE TROUGH		CONDUIT IS SHARED WITH MULTIPLE BRANCH CIRCUITS IF CONDUIT LENGTH IS COMPLIANT WITH NEC 310.15(C)(1)(b)
P165-01	(1)1"	PVC/RGS	(1)#8, (1)#8NEU, (1)#8G	XHHW-2	WIRE TROUGH	HH-112	MH-E1, MH-E7, MH-E8	SPLICE WITH P165 IN WIRE TROUGH, LARGER CONDUCTOR DUE TO LONG CIRCUIT LENGTH VOLTAGE DROP, SITE LIGHTING FOR GATE 2, RGS WHERE EXPOSED
P165-02	(1)1"	PVC/RGS	(1)#12, (1)#12NEU, (1)#12G	XHHW-2	HH-112	LP-12		SPLICE WITH P165-01 IN HH 109, SITE LIGHTING FOR GATE 2, RGS WHERE EXPOSED
P166	(1)1"	PVC	(1)#12, (1)#12NEU, (1)#12G	XHHW-2	MDP	ATS-1		BRANCH CIRCUIT FOR ATS STRIP HEATER.
P167	(1)1"	PVC	(1)#12, (1)#12NEU, (1)#12G	XHHW-2	MDP	PSE AMR/AMI REPEATER ENCLOSURE RECEPT		120V RECEPTACLE.
P168	(1)1"	RGS PVC	(1)#12, (1)#12NEU, (1)#12G	XHHW-2	MDP	LTG-CP2		
P169 P169-01	(1)1"	PVC	(1)#12, (1)#12NEU, (1)#12G (1)#6, (1)#6NEU, (1)#6G		UTG-CP2  WIRE TROUGH	WIRE TROUGH  MH-E1	~~~~~	LARGER CONDUCTOR DUE TO LONG CIRCUIT LENGTH VOLTAGE DROP, RGS
P167A	(1)1"	PVC	(1)#12, (1)#12NEU, (1)#12G	XHHW-2	MDP	WIRE TROUGH		
P167A-01	(1)1"	PVC	(1)#10, (1)#10NEU, (1)#10G	XHHW-2	WIRE TROUGH	LP-06	HH-106	SPLICE WITH P167A IN WIRE TROUGH LARGER CONDUCTOR DUE TO LONG CIRCUIT LENGTH VOLTAGE DROP.

				COND	UIT AND CABLE SO	CHEDULE		v2.0
NUMBER	CONDUIT QTY & SIZE	CONDUIT TYPE	WIRE FILL	WIRE TYPE	FROM	ТО	VIA	REMARKS
P169-02	(1)1"	PVC	(1)#6, (1)#6NEU, (1)#6G		MH-E1	HH-110	MH-E7	LARGER CONDUCTOR DUE TO LONG CIRCUIT LENGTH VOLTAGE DROP
P169-03	(1)1"	PVC	(1)#12, (1)#12NEU, (1)#12G		HH-110	LP-10		
P169-04	(1)1"	PVC	(1)#6, (1)#6NEU, (1)#6G		HH-110	HH-109		LARGER CONDUCTOR DUE TO LONG CIRCUIT LENGTH VOLTAGE DROP
P169-05	(1)1"	PVC	(1)#12, (1)#12NEU, (1)#12G		HH-109	LP-09		
P201	(1) 3" (1) 2"	PVC / RGS	(2) #4/0, (1) #4/0 NEU, (1) #4 G PULL STRING	XHHW-2	MDP MDP	PBD-AB1 STUB-UP BELOW PBD-AB1		RGS WHERE EXPOSED PROVIDE THREADED PLUGS (BOTH ENDS) IN SPARE CONDUIT, RGS WHERE
F 202	(1) 2	FVC/RGS	FULL STRING		IVIDE	STOD-OF BELOW FBD-ABT		CONDUIT IS EXPOSED.
P203	(1) 2"	PVC / RGS	PULL STRING		JBOX-AB1	STUB UP BELOW PBD-AB1		PROVIDE THREADED PLUGS (BOTH ENDS) IN SPARE CONDUIT, RGS WHERE CONDUIT IS EXPOSED.
C201	(1) 1"	PVC / RGS	(16)#14, (1)#14 G	XHHW-2	HS-LCP (ATTENDANT BUILDING)	LTG-CP2 (EQUIPMENT RACK)	WIRE TROUGH, LTG-CP1 (EQUIPMENT RACK)	SEE LIGHTING CONTROL PANEL WIRING DIAGRAM, COIL AND STOW SPARE WIRING, CONDUIT AND WIRING PASS THRU WIRING TROUGH, RGS WHERE CONDUIT IS EXPOSED.
C202	(1) 1"	PVC / RGS	PULL STRING		STUB-UP CONDUIT 4'x8' PLYWOOD BOARD SERVER ROOM	STUB-UP BELOW METER-1 (EQUPIMENT RACK)		PROVIDE THREADED PLUGS (BOTH ENDS) IN SPARE CONDUIT, RGS WHERE CONDUIT IS EXPOSED.
C203	(1) 1"	PVC / RGS	PULL STRING		STUB-UP CONDUIT 4'x8' PLYWOOD BOARD SERVER ROOM	STUB-UP ADJACENT TO ATS-1 (EQUPIMENT RACK)		PROVIDE THREADED PLUGS (BOTH ENDS) IN SPARE CONDUIT, RGS WHERE CONDUIT IS EXPOSED.
C204(A)	(1) 1"	PVC / RGS	PULL STRING		STUB-UP SERVER ROOM, SEE DRAWING FOR LOCATION	WEST OUTBOUND SCALE AREA UNDERGROUND, SEE DRAWING FOR LOCATION		PROVIDE THREADED PLUGS (BOTH ENDS) IN SPARE CONDUIT, RGS WHERE CONDUIT IS EXPOSED.
C204(B)	(1)1"	PVC / RGS	PULL STRING		STUB-UP SERVER ROOM, SEE DRAWING FOR LOCATION	WEST OUTBOUND SCALE AREA UNDERGROUND, SEE DRAWING FOR LOCATION		PROVIDE THREADED PLUGS (BOTH ENDS) IN SPARE CONDUIT, RGS WHERE CONDUIT IS EXPOSED.
C205	(1) 3"	PVC / RGS	PULL STRING		STUB-UP SERVER ROOM, SEE DRAWING FOR LOCATION	WEST OUTBOUND SCALE AREA UNDERGROUND, SEE DRAWING FOR LOCATION		PROVIDE THREADED PLUGS (BOTH ENDS) IN SPARE CONDUIT, RGS WHERE CONDUIT IS EXPOSED.
C206(A)	(1) 1"	PVC / RGS	PULL STRING		STUB-UP SERVER ROOM, SEE DRAWING FOR LOCATION	EAST INBOUND SCALE AREA UNDERGROUND, SEE DRAWING FOR LOCATION		PROVIDE THREADED PLUGS (BOTH ENDS) IN SPARE CONDUIT, RGS WHERE CONDUIT IS EXPOSED.
C206(B)	(1) 1"		PULL STRING		STUB-UP SERVER ROOM, SEE DRAWING FOR LOCATION	EAST INBOUND SCALE AREA UNDERGROUND, SEE DRAWING FOR LOCATION		PROVIDE THREADED PLUGS (BOTH ENDS) IN SPARE CONDUIT, RGS WHERE CONDUIT IS EXPOSED.
C207	(1) 3"	PVC / RGS	PULL STRING		STUB-UP SERVER ROOM, SEE DRAWING FOR LOCATION	EAST INBOUND SCALE AREA UNDERGROUND, SEE DRAWING FOR LOCATION		PROVIDE THREADED PLUGS (BOTH ENDS) IN SPARE CONDUIT, RGS WHERE CONDUIT IS EXPOSED.
C208	(1) 2"	PVC / RGS	PULL STRING & INNERDUCT		STUB-UP SERVER ROOM, SEE DRAWING FOR LOCATION	JBOX-AB1		PROVIDE THREADED PLUGS (BOTH ENDS) IN SPARE CONDUIT, RGS WHERE CONDUIT IS EXPOSED.
P211	(1)1"C	PVC/RGS	(2)#8,(1)#8N, (1)#10G	XHHW-2	PBD-AB1	HPIU-1 (OUTDOOR)	OUTDOOR DISCONNECT SWITCH	POWER INDOOR UNIT THRU OUTDOOR UNIT.
P213	(1)1"C	PVC/RGS	(2)#8,(1)#8N, (1)#10G	XHHW-2	PBD-AB1	ACCU-1 (OUTDOOR)	OUTDOOR DISCONNECT	POWER INDOOR UNIT THRU OUTDOOR
						,	SWITCH INDOOR DISCONNECT	UNIT.
P214	(1)1"C	EMT	(2)#10, (1)#10G	XHHW-2	PBD-AB1	WH-1	SWITCH INDOOR DISCONNECT	
P216	(1)1"C	EMT	(2)#8, (1)#10G	XHHW-2	PBD-AB1	DH-1	SWITCH	
P301	(1) 2"	PVC / RGS	(2) #2/0, (1) #2/0 NEU, (1) #4 G	XHHW-2	MDP	PBD-LH1	JBOX-AB1	LARGER CONDUCTORS FOR LONG CIRCUIT LENGTH VOLTAGE DROP. USE JBOX-AB1 AND INSULATED CONNECTORS TO ACCOMMODATE DIFFERENT WIRE SIZES. RGS WHERE EXPOSED.
P302	(1) 2"	PVC / RGS	PULL STRING		MDP	STUB-UP BELOW PBD-LH1	JBOX-AB1	PROVIDE THREADED PLUGS (BOTH ENDS) FOR SPARE CONDUIT
P303	(1)1"	PVC / RGS	PULL STRING		PBD-LH1	LHHW BLDG, SEE DRAWING		PROVIDE THREADED PLUGS (BOTH
P304	(1)1"	PVC / RGS	PULL STRING		PBD-LH1	FOR STUB-UP LOCATION  LHHW BLDG, SEE DRAWING FOR STUB-UP LOCATION		ENDS) FOR SPARE CONDUIT PROVIDE THREADED PLUGS (BOTH ENDS) FOR SPARE CONDUIT
	-							ISSUE FOR E

R. ROHLER REVISIONS **DRAWN** J. VONDERAHE CHECKED C. WITTMAN **APPROVED**K. HUFNAGEL

ONE INCH AT FULL SCALE.
IF NOT, SCALE ACCORDINGLY FILE NAME \_PMX\_E\_R20\_NEW.rvt JOB No. 553-1578-155 DATE MARCH 2025

KITSAP COUNTY
DEPT. OF PUBLIC WORKS
614 DIVISION STREET MS-26
PORT ORCHARD, WA 98366
TEL:(360) 337-5777 FAX:(360) 337-4867

Parametrix
719 SECOND AVENUE SE, SUITE 100 | SEATTLE, WA 98104 P 206.394.3700 WWW.PARAMETRIX.COM

PROJECT NAME

SILVERDALE RECYCLING AND GARBAGE FACILITY REDEVELOPMENT

KITSAP COUNTY, WASHINGTON

**ELECTRICAL CONDUIT AND CABLE** SCHEDULE 3

DRAWING NO. 223 **of** 239

				COND	UIT AND CABLE SO	CHEDULE		v2.0
NUMBER	CONDUIT QTY & SIZE	CONDUIT TYPE	WIRE FILL	WIRE TYPE	FROM	ТО	VIA	REMARKS
P305	(1)1"	PVC/RGS	(2)#8, (1)#10G	XHHW-2		WH-2	VIA	KLINAKKO
C301	(1) 2"	PVC / RGS	(2)CAT6	CAT6	MCS-JB1 ETHERNET EXTENDED JBOX	(ACS-7) REMOTE ATTENDANT CALL STATION LHHW BLDG	MH-C1, MH-C9	RGS WHERE EXPOSED, PROVIDE INNERDUCT
C302	(1) 2"	PVC / RGS	PULL STRING & INNERDUCT		SERVER ROOM, ATTENDANT BLDG, SEE DRAWING FOR LOCATION	STORAGE ROOM, LHHW BLDG SEE DRAWING FOR STUB- UP LOCATION	MH-C1, MH-C9	PROVIDE THREADED PLUGS (BOTH ENDS) IN SPARE CONDUIT, RGS WHERI EXPOSED
C303	(1)3"	PVC / RGS	PULL STRING & INNERDUCT		MCS-JB1 ETHERNET EXTENDED JBOX	MH-C1		PROVIDE THREADED PLUGS (BOTH ENDS) IN SPARE CONDUIT, RGS WHERI EXPOSED
P401	(1) 3"	RGS	(2) #4/0, (1) #4/0 NEU, (1) #4/0G	XHHW-2	MDP	JBOX-AB1		LARGER CONDUCTORS FOR LONG CIRCUIT LENGTH VOLTAGE DROP. RGS WHERE EXPOSED
P402	(1) 3"	PVC/RGS	(2) #500 KCMIL, (1) #500 KCMIL NEU, (1) #500G	XHHW-2	JBOX-AB1	JBOX-WS1	MH-E1, MH-E5	SPLICE TO P401 AT JBOX-AB1 LARGER CONDUCTORS FOR LONG CIRCUIT LENGTH VOLTAGE DROP. RGS WHERE EXPOSED
P403	(1) 3"	PVC/RGS	(2) #4/0, (1) #4/0 NEU, (1) #4/0G	XHHW-2	JBOX-WS1	PBD-WS1		LARGER CONDUCTORS FOR LONG CIRCUIT LENGTH VOLTAGE DROP. RGS WHERE EXPOSED
P404	(1) 3"	PVC/RGS	PULL STRING		JBOX-AB1	JBOX-WS1		PROVIDE THREADED PLUGS (BOTH ENDS OF CONDUIT) IN SPARE CONDUIT
P405	(1)1"	PVC/RGS	PULL STRING		PBD-WS1	OPERATOR WARMING STATION, SEE DRAWING FOR LOCATOIN	JBOX-WS1	PROVIDE THREADED PLUGS (BOTH ENDS OF CONDUIT) IN SPARE CONDUIT
P406	(1)1"	PVC/RGS	PULL STRING		PBD-WS1	OPERATOR WARMING STATION, SEE DRAWING FOR LOCATOIN	JBOX-WS1	PROVIDE THREADED PLUGS (BOTH ENDS OF CONDUIT) IN SPARE CONDUIT
C401	(1) 2"	PVC / RGS	(2)CAT6	CAT6	MCS-JB1 ETHERNET EXTENDED JBOX	(ACS-2) REMOTE ATTENDANT CALL STATION OPERATOR WARMING STATION	MH-C1, MH-C5	RGS WHERE EXPOSED, PROVIDE INNERDUCT
C402	(2) 3"	PVC / RGS	PULL STRING & INNERDUCT		SERVER ROOM, ATTENDANT BLDG, SEE DRAWING FOR LOCATION	COMM-WS1, OPERATOR WARMING STATION	MH-C1, MH-C5	PROVIDE THREADED PLUGS (BOTH ENDS) IN SPARE CONDUIT, RGS WHERI EXPOSED
C403	(1) 1"	PVC / RGS	PULL STRING		COMM-WS1, OPERATOR WARMING STATION	OPERATOR WARMING STATION, SEE DRAWING FOR LOCATOIN		PROVIDE THREADED PLUGS (BOTH ENDS) IN SPARE CONDUIT, RGS WHER EXPOSED
C404	(1) 1"	PVC / RGS	PULL STRING		COMM-WS1, OPERATOR WARMING STATION	OPERATOR WARMING STATION, SEE DRAWING FOR LOCATOIN		PROVIDE THREADED PLUGS (BOTH ENDS) IN SPARE CONDUIT, RGS WHER EXPOSED
C405	(1) 1"	PVC / RGS	PULL STRING		COMM-WS1, OPERATOR WARMING STATION	OPERATOR WARMING STATION, SEE DRAWING FOR LOCATOIN		PROVIDE THREADED PLUGS (BOTH ENDS) IN SPARE CONDUIT, RGS WHER EXPOSED
P501	(1)1"	PVC/RGS	(2)#8, (1)#8 NEU, (1)#8 G	XHHW-2	PBD-WS1	PBD-RSA	JBOX-WS1, MH-E5	RGS WHERE EXPOSED PROVIDE THREADED PLUGS (BOTH
C501	(1)1"	PVC/RGS	PULL STRING		COMM-WS1	REFUSE SHED A	MH-C5	ENDS) IN SPARE CONDUIT, RGS WHERE EXPOSED
P502	(1)1"	PVC/RGS	PULL STRING		PBD-WS1	STUB UP BELOW PBD-RSA	JBOX-WS1, MH-E5	PROVIDE THREADED PLUGS (BOTH ENDS) IN SPARE CONDUIT, RGS WHERE EXPOSED
P511	(1)1"	RGS	(1)#12, (1)#12 NEU, (1)#12 G	XHHW-2	PBD-RSA	LTG, EXTERIOR, REAR OF BLDG		
P512	(1)1"	RGS	(1)#12, (1)#12 NEU, (1)#12 G	XHHW-2		LTG, INTERIOR	LIGHT SWITCH	
P513 P514	(1)1" (1)1"	RGS RGS	(1)#12, (1)#12 NEU, (1)#12 G (1)#12, (1)#12 NEU, (1)#12 G	XHHW-2 XHHW-2	PBD-RSA	RECEPTS, INTERIOR RECEPT, EXTERIOR		
P601	(1)1"	PVC/RGS	(2)#8, (1)#8 NEU, (1)#8 G	XHHW-2		PBD-RSB	JBOX-WS1, MH-E5	RGS WHERE EXPOSED PROVIDE THREADED PLUGS (BOTH
C601	(1)1"	PVC/RGS	PULL STRING		COMM-WS1	REFUSE SHED B	MH-C5	ENDS) IN SPARE CONDUIT, RGS WHERE EXPOSED
P602	(1)1"	PVC/RGS	PULL STRING		PBD-WS1	STUB UP BELOW PBD-RSB	JBOX-WS1, MH-E5	PROVIDE THREADED PLUGS (BOTH ENDS) IN SPARE CONDUIT, RGS WHERE EXPOSED
P611 P612	(1)1" (1)1"	RGS RGS	(1)#12, (1)#12 NEU, (1)#12 G (1)#12, (1)#12 NEU, (1)#12 G	XHHW-2 XHHW-2		LTG, INTERIOR RECEPTS, INTERIOR	LIGHT SWITCH	
P613	(1)1"	RGS	(1)#12, (1)#12 NEU, (1)#12 G	XHHW-2	PBD-RSB	RECEPT, EXTERIOR		
P701	(1)1"	PVC/RGS	(2)#8, (1)#8 NEU, (1)#8 G	XHHW-2	PBD-WS1	PBD-RSC	JBOX-WS1, MH-E5	RGS WHERE EXPOSED

				COI	NDUIT AND CABLE	SCHEDULE		v2.0
NUMBER	CONDUIT QTY & SIZE	CONDUIT TYPE	WIRE FILL	WIRE TYPE	FROM	ТО	VIA	REMARKS
C701	(1)1"	PVC/RGS	PULL STRING		COMM-WS1	REFUSE SHED C	MH-C5	PROVIDE THREADED PLUGS (BOTH ENDS) IN SPARE CONDUIT, RGS WHERE EXPOSED
P702	(1)1"	PVC/RGS	PULL STRING		PBD-WS1	STUB UP BELOW PBD-RSC	JBOX-WS1, MH-E5	PROVIDE THREADED PLUGS (BOTH ENDS) IN SPARE CONDUIT, RGS WHERE EXPOSED
P711	(1)1"	RGS	(1)#12, (1)#12 NEU, (1)#12 G	XHHW-2	PBD-RSC	EXTERIOR LTG, REAR BLDG		
P712	(1)1"	RGS	(1)#12, (1)#12 NEU, (1)#12 G	XHHW-2	PBD-RSC	LTG, INTERIOR	LIGHT SWITCH	
P713	(1)1"	RGS	(1)#12, (1)#12 NEU, (1)#12 G	XHHW-2	PBD-RSC	RECEPTS, INTERIOR		
P714	(1)1"	RGS	(1)#12, (1)#12 NEU, (1)#12 G	XHHW-2	PBD-RSC	RECEPT, EXTERIOR		
P801	(1)1"	PVC/RGS	(2)#8, (1)#8 NEU, (1)#8 G	XHHW-2	PBD-WS1	PBD-RSD	JBOX-WS1, MH-E5	RGS WHERE EXPOSED
C801	(1)1"	PVC/RGS	PULL STRING		COMM-WS1	REFUSE SHED D	MH-C5	PROVIDE THREADED PLUGS (BOTH ENDS) IN SPARE CONDUIT, RGS WHERE EXPOSED
P802	(1)1"	PVC/RGS	PULL STRING		PBD-WS1	STUB UP BELOW PBD-RSD	JBOX-WS1, MH-E5	PROVIDE THREADED PLUGS (BOTH ENDS) IN SPARE CONDUIT, RGS WHERE EXPOSED
P803	(1)1"	PVC/RGS	(1)#10, (1)#10 NEU, (1)#10 G	XHHW-2	PBD-RSD	MAINTENANCE SHED DISCONNECT SWITCH		RGS WHERE EXPOSED, INTERIOR MAINTENANCE SHED CONDUIT WILL BE ROUTED AS 1" RGS. SEE DWG C40.03 FOR UNDERGROUND STORM DRAIN UTILITIY SAME AREA.
P812	(1)1"	RGS	(1)#12, (1)#12 NEU, (1)#12 G	XHHW-2	PBD-RSD	LTG, INTERIOR	LIGHT SWITCH	
P813	(1)1"	RGS	(1)#12, (1)#12 NEU, (1)#12 G	XHHW-2	PBD-RSD	RECEPTS, INTERIOR		
P814	(1)1"	RGS	(1)#12, (1)#12 NEU, (1)#12 G	XHHW-2	PBD-RSD	RECEPT, EXTERIOR		
P901	(1)1"	EMT	(1)#12, (1)#12 NEU, (1)#12 G	XHHW-2	PBD-AB1	GAS DETECTOR / CONTROLLER	TOGGLE SWITCH	PROVIDE TOGGLE DISCONNECT SWITCH ADJACENT TO GAS DETECTOR / CONTROLLER, SEE DWG M10.05.
P902	(1)1"	EMT	(1)#12, (1)#12 NEU, (1)#12 G	XHHW-2	PBD-AB1	RELAY CONTROL PANEL	TOGGLE SWITCH	PROVIDE TOGGLE DISCONNECT SWITCH ADJACENT TO RELAY CONTROL PANEL, SEE DWG M10.05.
P903	(1)1"	EMT	(4)#12, (4)#12 NEU, (4)#12 G	XHHW-2	RELAY CONTROL PANEL	GAS DETECTOR / CONTROLLER		COIL AND STOW SPARE WIRING, SEE DWG M10.05.
P904	(1)1"	EMT	(2)#12, (2)#12 NEU, (2)#12 G	XHHW-2	RELAY CONTROL PANEL	HIGH AND LOW ALERT RED WARNNG WALL LIGHTS	CONDUIT BODY, TYPE T. OR JUNCTION BOX.	TO PROVIDE POWER TO WARNING WALL MOUNTED LIGHTS.
P166A P166A-01	, ,	PVC PVC	(1)#12, (1)#12 NEU, (1)#12 G (1)#8, (1)#8 NEU, (1)#8 G	XHHW-2 XHHW-2	MDP WIRE TROUGH	WIRE TROUGH HH-E8		SPLICE WITH P166A IN WIRE TROUGH LARGER CONDUCTOR DUE TO LONG CIRCUIT LENGTH VOLTAGE DROP.
P166A-02	· /	PVC	(1)#12, (1)#12 NEU, (1)#12 G	XHHW-2	HH-E8	LP-11		SPLICE WITH P166A-01. SEE DWG E14.01.
P166A-03 P166A-04		PVC PVC	(1)#8, (1)#8 NEU, (1)#8 G (1)#12, (1)#12 NEU, (1)#12 G	XHHW-2 XHHW-2	HH-E1 HH-107	HH-107 LP-07		SPLICE WITH P166A. SEE DWG E1. SPLICE WITH P166A-03. SEE DWG E14.01.
TT							***************************************	


	REVISIONS	DATE	BY	<b>DESIGNED</b> R. ROHLER
1	ADDENDUM No. 3	12/9/2025	RWR	DRAWN
				J. VONDERAHE
				CHECKED
				C. WITTMAN
				<b>APPROVED</b> K. HUFNAGEL

ONE INCH AT FULL SCALE.
IF NOT, SCALE ACCORDINGLY

FILE NAME
PMX E R20 NEW.rvt

JOB No.
553-1578-155

DATE
MARCH 2025

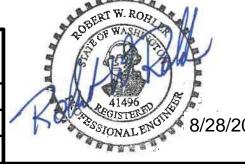



Parametrix
719 SECOND AVENUE SE, SUITE 100 | SEATTLE, WA 98104
P 206.394.3700
WWW.PARAMETRIX.COM


PROJECT NAME

SILVERDALE RECYCLING AND GARBAGE FACILITY REDEVELOPMENT

KITSAP COUNTY, WASHINGTON

ELECTRICAL CONDUIT AND CABLE SCHEDULE 4

DRAWING NO. 224 OF 239

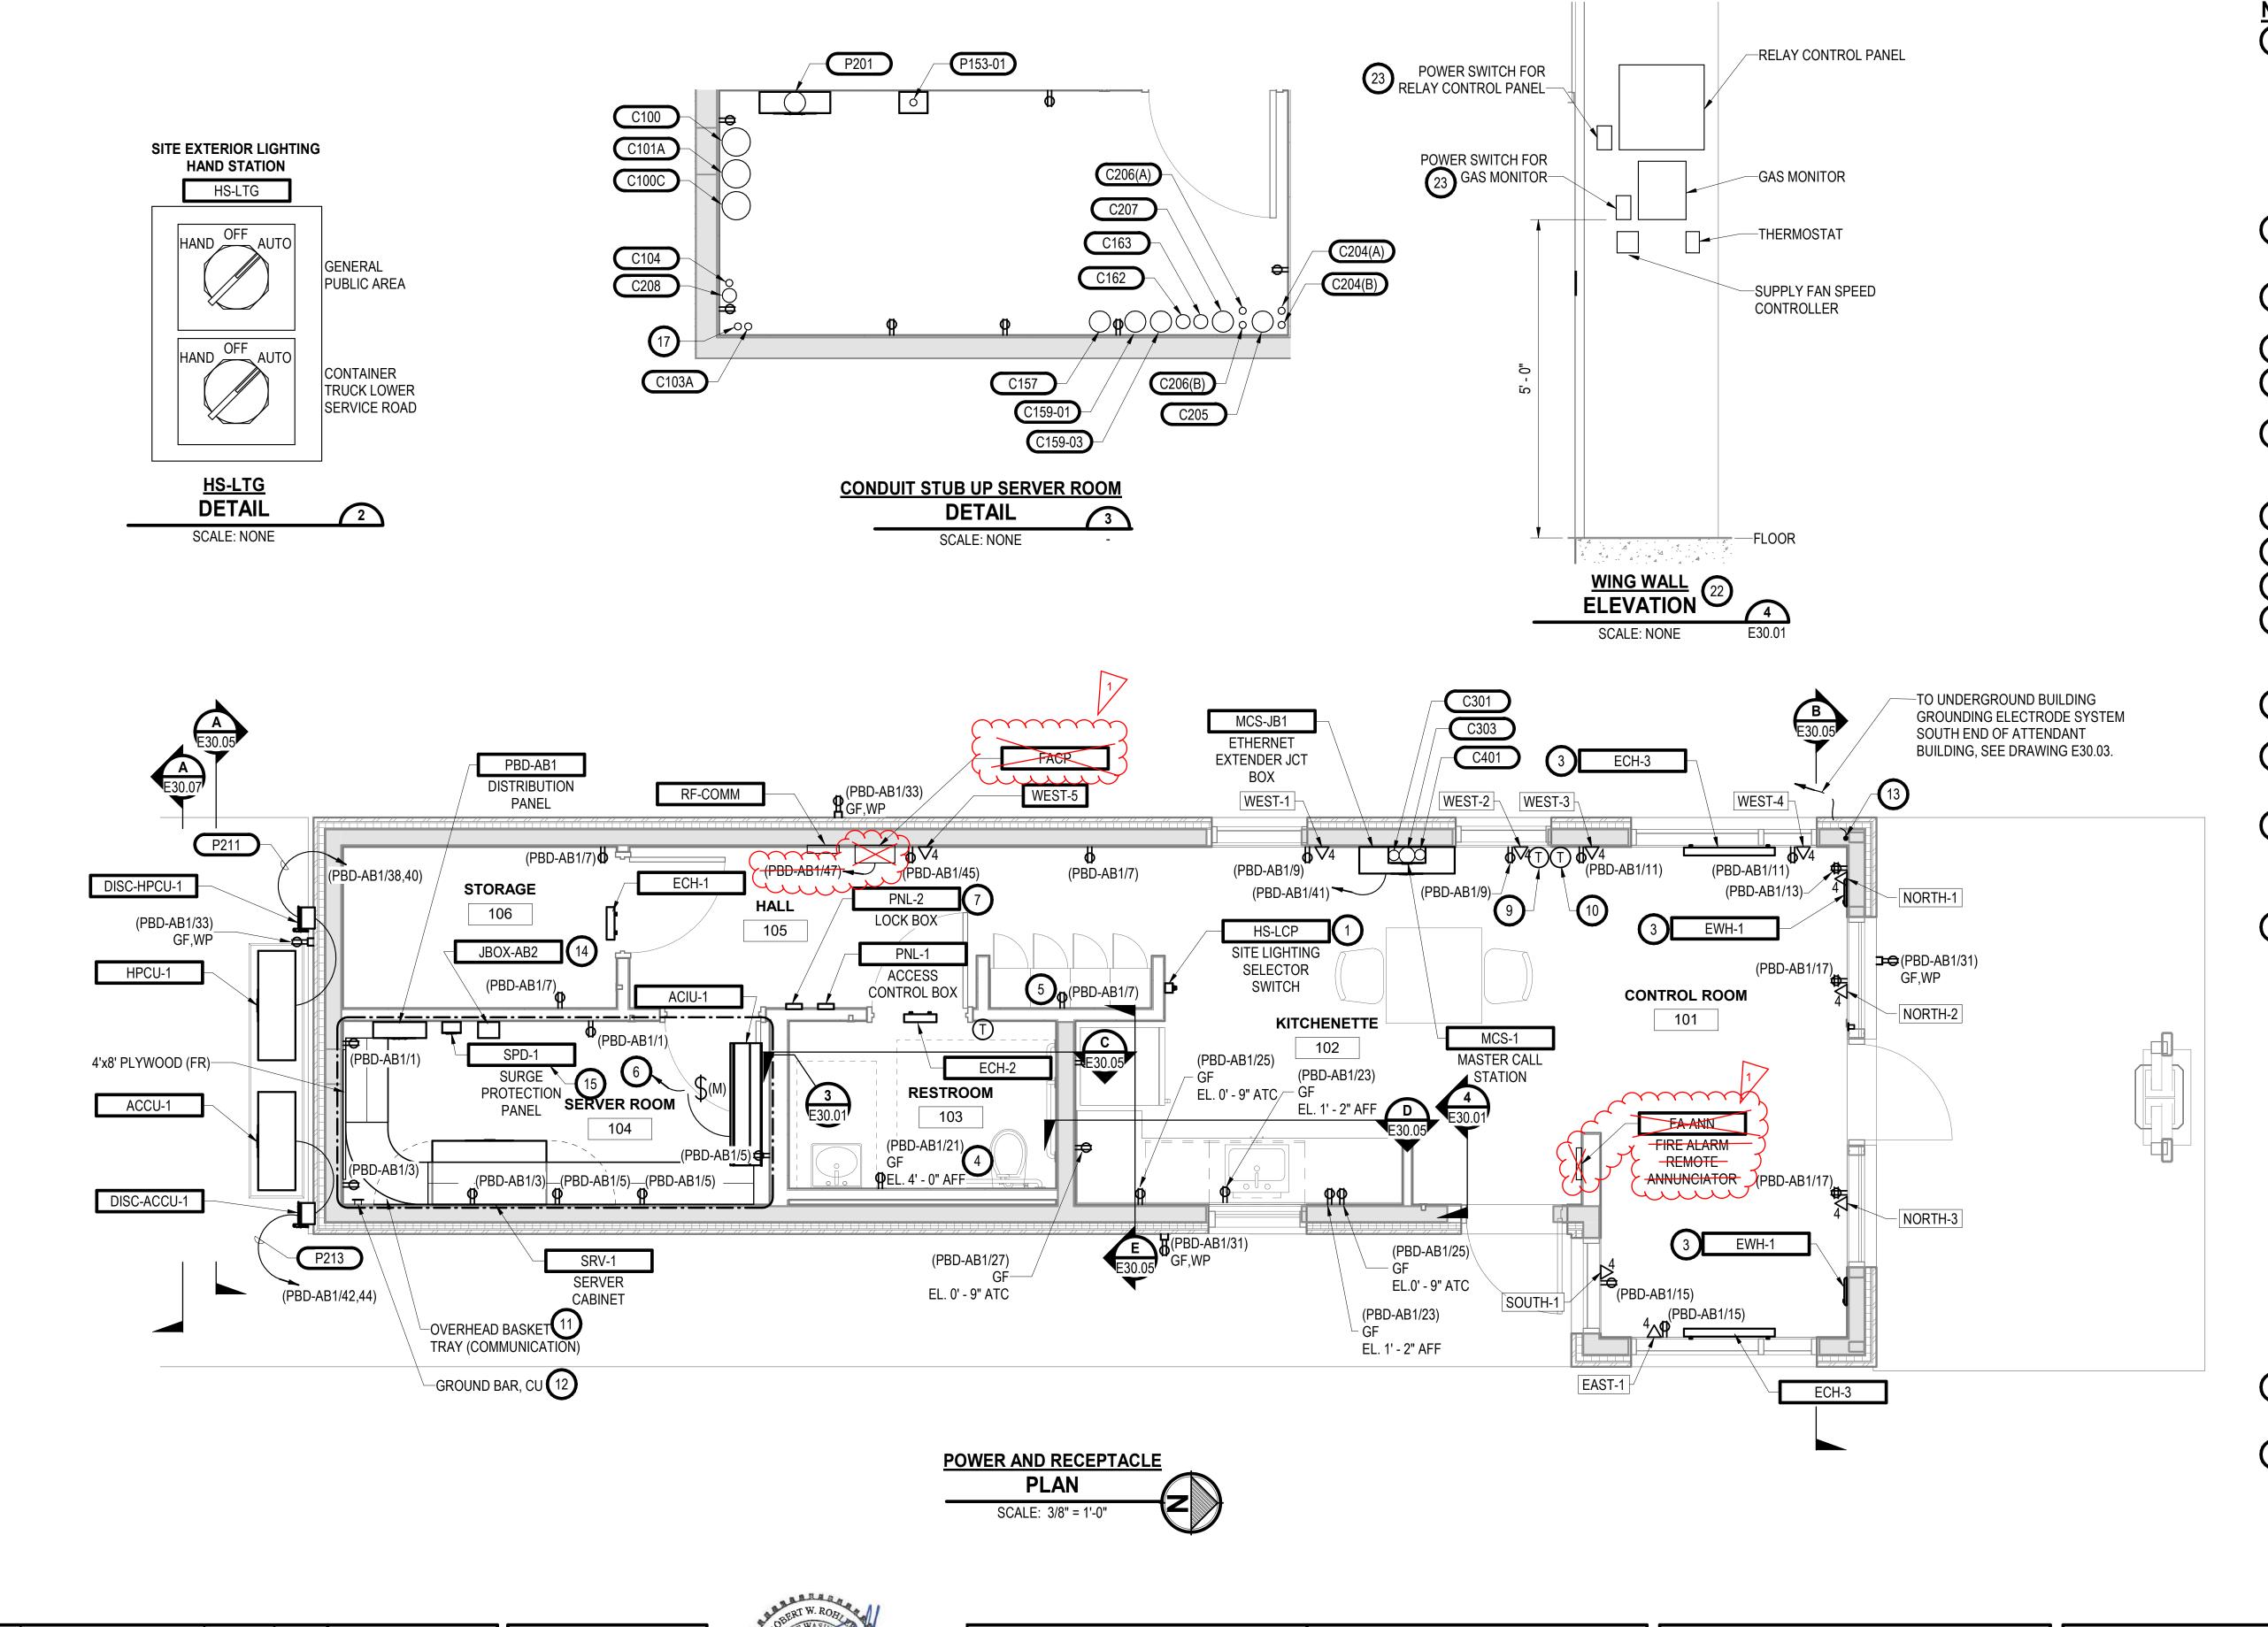

NOTES:

SITE EXTERIOR LIGHTING SELECTOR SWITCHES (H-O-A) FOR BOTH GENERAL PUBLIC AREA AND FOR LOWER TRUCK CONTAINER SERVICE ROAD. THESE SWITCHES CONTROL THE TWO LIGHTING CONTROL PANELS LOCATED ON THE OUTDOOR ELECTRICAL EQUIPMENT RACK. FOR SWITCH CONFIGURATION SEE DETAIL 2.

2. ALL INTERIOR RECEPTACLES AND LIGHT SWITCHES SHALL BE INSTALLED IN RECESSED, IN-WALL MOUNTING ELECTRICAL

3 ELECTRIC WALL HEATERS AND ELECTRIC COVE HEATERS ARE ONLY AVAILABLE WHEN CONTROL ROOM HEATER HPIU-1 IS ON. POWERED BY PBD-AB1/14 VIA RELAY BOX.

4 LOCATE RECEPTACLE NOT TO INTERFERE WITH MIRROR OR

5 LOCATE RECEPTACLE ABOVE LOCKERS.

6 INDOOR UNIT POWERED BY OUTDOOR CONDENSING UNIT. LOCATE SWITCH ON WALL NEAR ACIU-1.

O LOCK BOX CONTAINS KEY FOR ACCESS INTO SERVER ROOM IN CASE OF LOSS OF POWER.

8. SEE NETWORK SCHEDULE FOR WALL NETWORK OUTLETS.

(9) THERMOSTAT FOR EWH-1 SEE MECHANICAL DWG.

(10) THERMOSTAT FOR ECH-3, SEE MECHANICAL DWG.

(11) MOUNT BASKET TRAY 7'-10" AFF.

MOLINT 12" COPPER GROLIND RAP 8'-8" AE

MOUNT 12" COPPER GROUND BAR 8'-8" AFF. BOND GROUND BAR TO UNDERGROUND GROUNDING ELECTRODE SYSTEM, SEE DWG E30.03. PROVIDE GROUNDING BAR LABEL, "GROUNDING FOR COMMUNICATION SYSTEMS ONLY".

BOND GROUNDING ELECTRODE SYSTEM TO BUILDING STEEL COLUMN.

JBOX-AB2 IS FOR THE EXTERIOR LIGHTING CONTROLLED BY THE LIGHTING CONTROL PANEL LOCATED AT THE EQUIPMENT RACK SOUTH OF THE ATTENDANT BLDG.

(15) SPD-1 IS TO PROVIDE PROTECTION FOR PBD-AB1.

16. CONTRACTOR SHALL PROVIDE CONDUIT AND WIRING FOR ATTENDANT BUILDING. CONDUIT AND WIRING FOR ATTENDANT BUILDING NOT SHOWN FOR DRAWING CLARITY.

(17) PVC CONDUIT FOR GROUND BAR GROUND CONDUCTOR.

- 18. CONDUIT AND CABLES FOR LIGHTING, RECEPTACLES, AND HVAC ARE NOT SHOWN ON DRAWING FOR DRAWING CLARITY. SEE PANELBOARD SCHEDULE FOR AMPERAGE RATING OF CIRCUIT BREAKER THAT FEEDS EQUIPMENT FOR DETERMINING CONDUIT AND CABLE SIZE.
- 19. MECHANICAL CONTROLS CONTRACTOR SHALL PROVIDE RELAYS FOR HVAC EQUIPMENT. ELECTRICAL CONTRACTOR SHALL PROVIDE DISCONNECT SWITCHES AND LINE VOLTAGE SIDE WIRING TO RELAYS. MECHANICAL CONTRACTOR SHALL PROVIDE LOW VOLTAGE SIDE WIRING TO RELAYS. ELECTRICA CONTRACTOR SHALL WORK WITH MECHANICAL CONTROLS CONTRACTOR TO INSURE PROPERLY WORKING HVAC SYSTEM.
- 20. NETWORK COMMUNICATION CABLES TO THE NETWORK DATA JACKS SHALL BE ROUTED TO THE SERVER RACK (SRV-1) IN 1 INCH CONDUIT.
- 21. PROVIDE #6 GROUND CONDUCTOR FROM THE GROUND BAR TO THE 4' X 8' PLYWOOD. THE GROUND CONDUCTOR SHALL BE XHHW OR THHN AND HAVE GREEN COLOR INSULATION. COIL AN 8' PIGTAIL OF EXTRA GROUND CONDUCTOR AT THE PLYWOOD FOR THE COMMUNICATION PROVIDER USE.
- SEE MECHANICAL SHEETS M10-05 AND M30.03 FOR HVAC EQUIPMENT ON THIS WING WALL. SEE CONDUIT AND CABLE SCHEDULE FOR WIRING.
- PROVIDE SINGLE GANG SWITCH COVER, WEATHERPROOF, PVD, CANTEX PART NO. 513331 OR APPROVED EQUAL. PROVIDE SWITCH FUNCTION LABEL.

**ISSUE FOR BID** 


REVISIONS
DATE
BY
DESIGNED
R. ROHLER
R. ROHLER
DRAWN
J. VONDERAHE
CHECKED
C. WITTMAN
APPROVED
K. HUFNAGEL

ONE INCH AT FULL SCALE.
IF NOT, SCALE ACCORDINGLY
FILE NAME
Silverdale RAGF-AB.rvt

JOB No.
553-1578-155

DATE
MARCH 2025



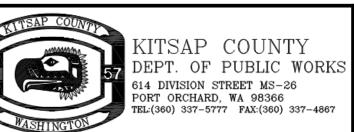

Parametrix
719 SECOND AVENUE SE, SUITE 100 | SEATTLE, WA 98104
P 206.394.3700
WWW.PARAMETRIX.COM

SILVERDALE RECYCLING AND

GARBAGE FACILITY
REDEVELOPMENT

KITSAP COUNTY, WASHINGTON

ATTENDANT BUILDING POWER AND RECEPTACLE PLAN

**DRAWING NO.** 230 **OF** 239

E30.01

